

SOUTH SALT LAKE CITY HALL INTERIOR OFFICE REMODEL

ADDENDUM #2

1. Please use the attached sheet D102 Rev. 1 for the Community Development area. This sheet is to replace original D102.
2. It is anticipated that both areas will be run as a single project. Please provide separate pricing for both areas as defined in the bid schedules. This breakdown is simply for internal budgetary purposes.
3. The glass wall/door system as shown on sheet G001 and note 23 on sheet D103 will be procured and installed by the contractor. Product information and manufacturer listed on sheet G001.
4. All data pulls will be done by owner. Contractor to provide raceway and pull strings.
5. Return all removed doors to the owner for storage.
6. All bidders to provide a \$10,000 allowance for fire alarm modifications, to be distributed as \$5,000 to each area on the bid schedule.
7. Detail 3/D103 – Existing lower cabinetry to be removed.
Detail 2/D103, 1/D104 – New lower cabinetry to be built and installed by contractor.

| NO. | DATE | DESCRIPTION |
|-----|----------|-------------|
| 1. | 05/27/21 | EXISTING |
| 2. | 12/15/22 | CD SET |
| | | |
| | | |
| | | |


| ISSUED | NO. | DATE | DESCRIPTION |
|--------|-----|------|-------------|
| | | | |
| | | | |
| | | | |
| | | | |

KEYNOTES


NEW WORK

NOTE: NOT ALL KEYNOTES WILL BE USED


- 1 8'-0" ALEO TYPE LP8-LPA-8-UX-100-8-CCT FIELD ADJUST-WH (2) LPA-ACCSY-PK (1) LPA-LNK-BRK
- 2 EXIT SIGN - RELZTE-1-R-C-A-EM - RED - CLEAR SINGLE FACE - ALUMINUM TRIM
- 3 PROVIDE BLOCKING FOR WALL MOUNTED TV. REFER TO INTERIOR ELEVATIONS.
- 4 EXISTING CEILING TILE, LIGHTS, AND CEILING ACCESSORIES TO REMAIN
- 5 KANOPI OPTIMA PLANT BASED 2X2 ACT - WHITE - INSTALL IN EXISTING GRID.
- 6 2X2 SUPPLY GRILLE - PRICE SPD-GR00038 - A-WHA ARMSTRONG WHITELUME - 15/16" TEGULAR TILE - 8" CONNECTION
- 7 2X2 RETURN GRILLE - PRICE SPD-GR00038 - A-WHA ARMSTRONG WHITELUME - 15/16" TEGULAR TILE
- 8 REMOVE EXISTING CEILING TILE AND CWB CEILING IN THIS AREA. COORDINATE NEW EAST WALL FOR BREAK LINE OF WHERE EXISTING CEILING IS TO REMAIN
- 9 CARPET TILE - SHAW CONTRACT - CHROMATONE TILE 18" x 36" SCARLET CHARCOAL - 07854 WITH ROPPE 4" COVED RUBBER BASE 148 STEEL GREY
- 11 REMOVE AND SALVAGE EXISTING DOOR AND FRAME. COORDINATE STORAGE WITH OWNER.
- 12 REUSE EXISTING DOOR, FRAME, AND HARDWARE FOR NEW OPENING 25
- 13 REPAIR DRYWALL AT NEW WALL LOCATION. PAINT TO MATCH EXISTING. NEW RUBBER BASE ON THIS SIDE OF WALL TO MATCH EXISTING.
- 15 LVT - SHAW CONTRACT - RETHINK. 9" X 36" COLOR(S) SMART(33856) & METAL(33330) WITH ROPPE 4" COVED RUBBER BASE - 148 STEEL GRAY
- 16 1/4" CUT EXISTING SLAB AND PATCH BACK FOR NEW FLOOR POWER AND DATA OUTLET.
- 17 QUARTZ COUNTERTOP - SEE SHEET D105 FOR SPECS
- 18 REUSE EXISTING DOOR, FRAME, AND HARDWARE FOR NEW OPENING 28
- 19 MODIFY EXISTING CEILING TILE TO ACCOMMODATE NEW WALL
- 20 QUARTZ COUNTERTOP - CAESARSTONE FROSTY CARRINA - 5141
- 21 NEW SWINGING DOOR. SEE 3/D107
- 22 22 - EXISTING WORK STATIONS TO REMAIN
- 23 23 - SEE SHEET G001 FOR PRODUCT INFORMATION. CONTACT DOORS 22 FOR GLASS WALL BRACING REQUIREMENTS.
- 24 CEILING EXHAUST FAN. VERIFY CONNECTION TO EXISTING EXHAUST DUCT PRIOR TO ORDER.
- 25 REMOVE EXISTING DOOR AND FRAME. COORDINATE WITH OWNER FOR DISPOSAL
- 26 CUT WALL OPENING FOR NEW DOOR. REFRAME AS NEEDED

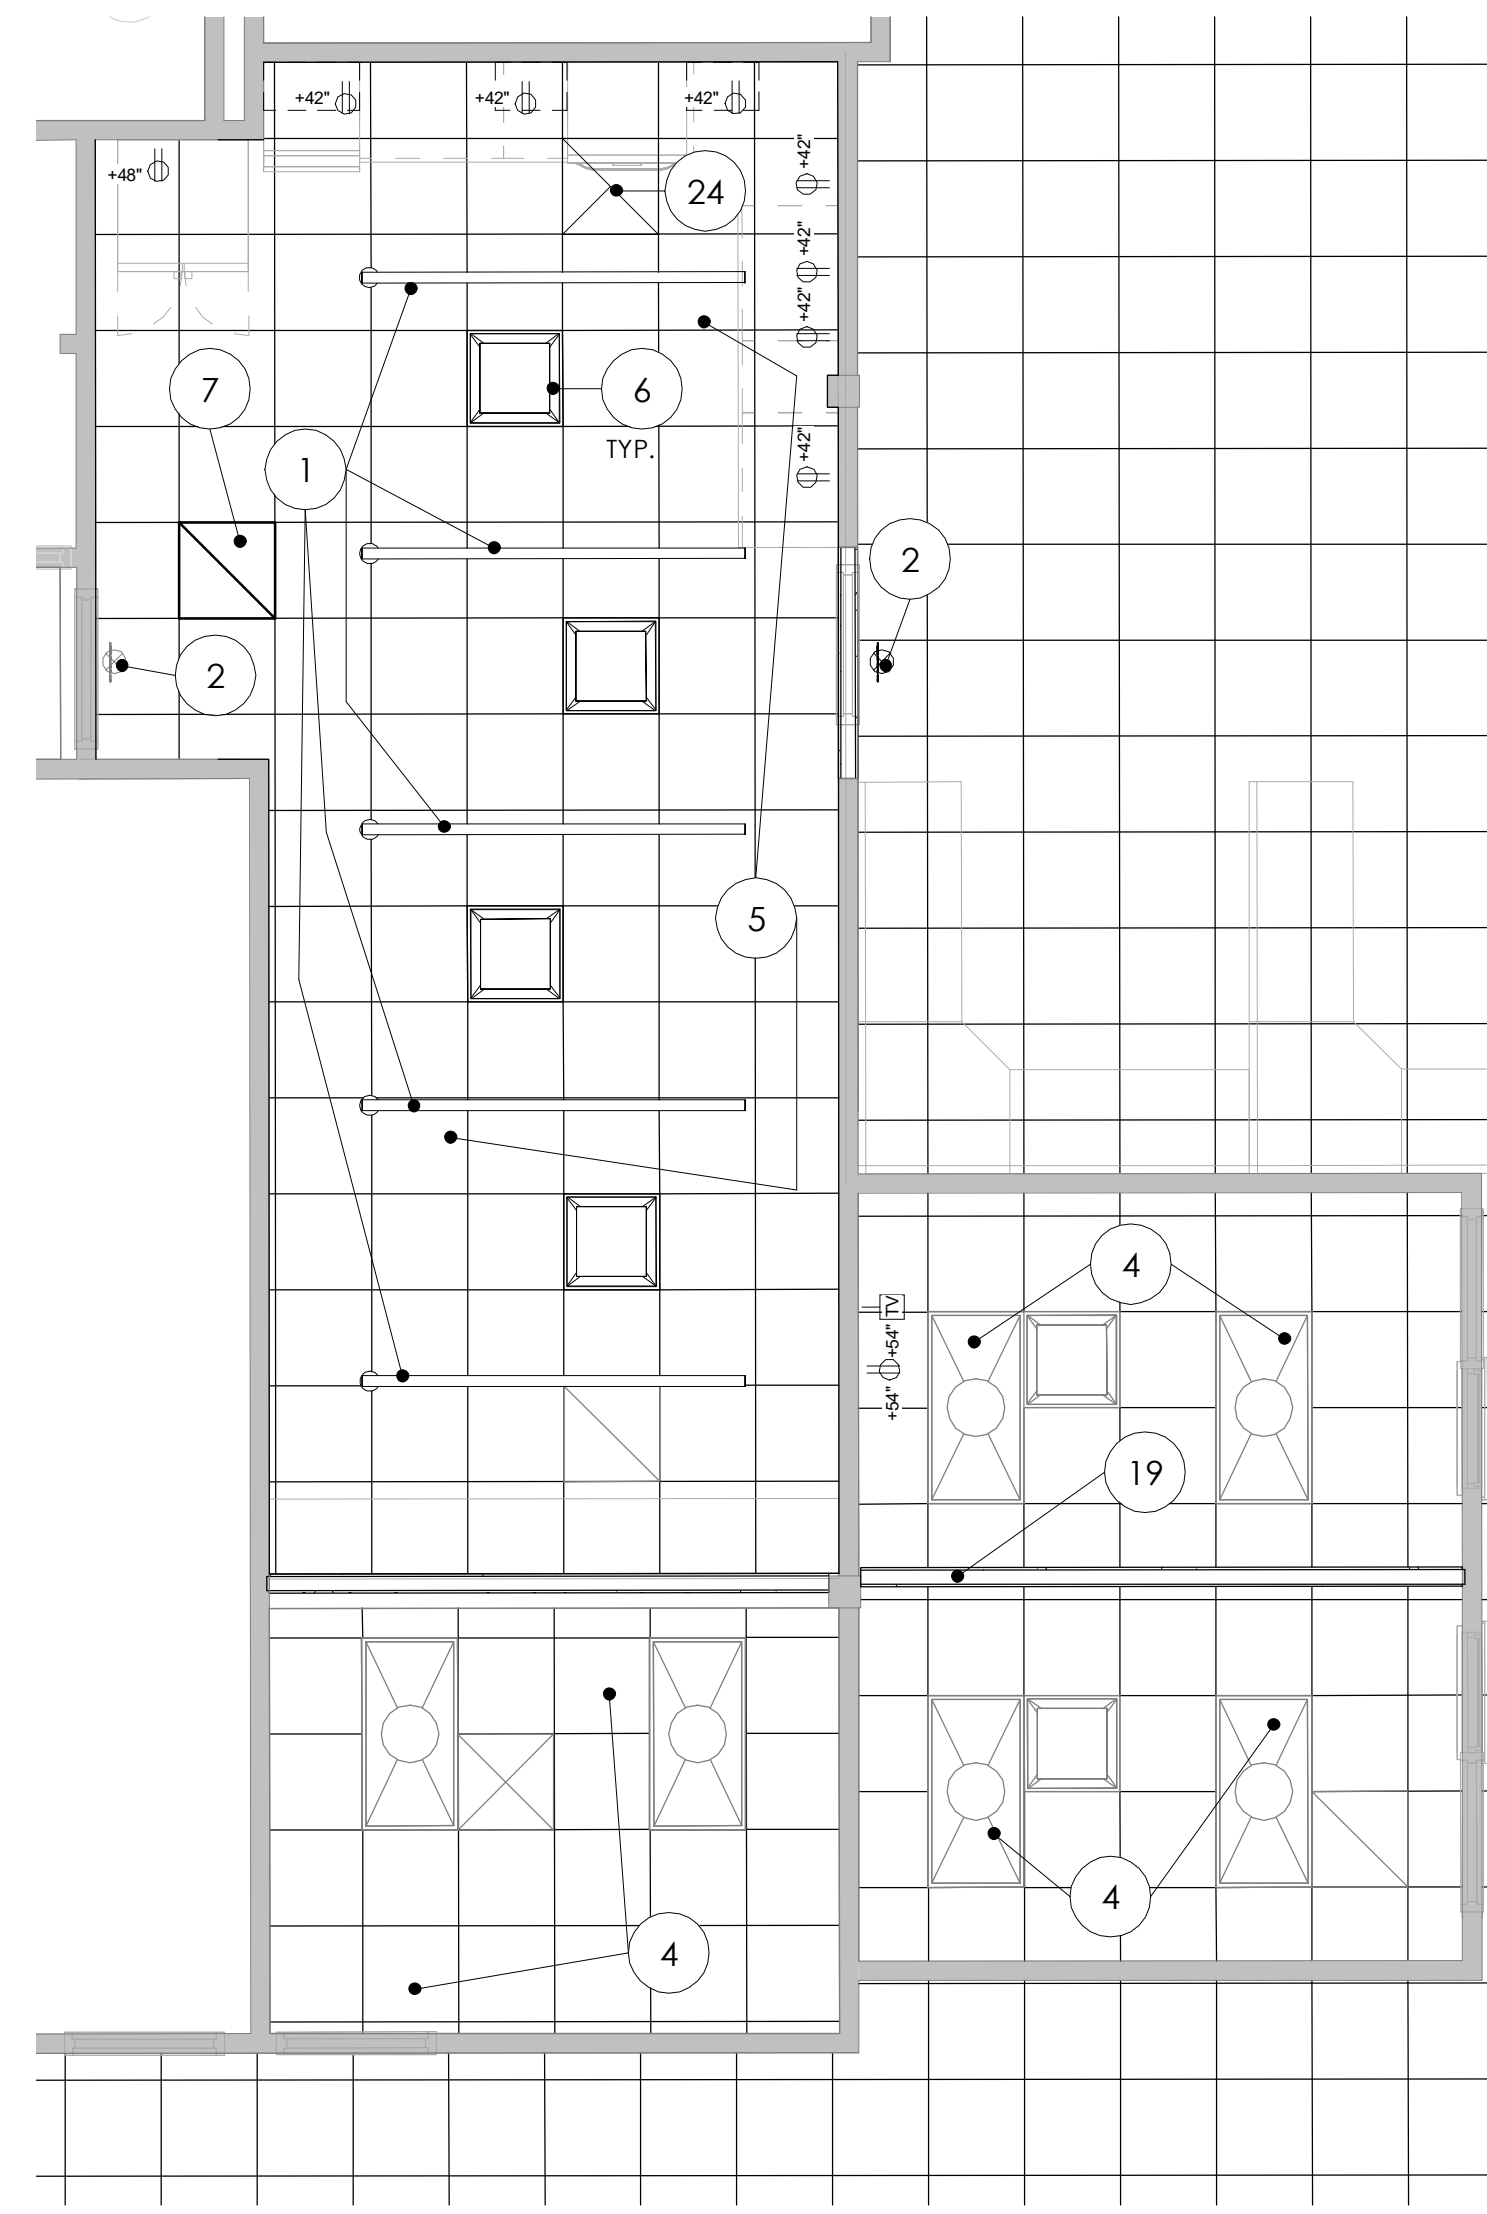


3 | BREAK ROOM REFLECTED CEILING PLAN
1/4" = 1'-0"

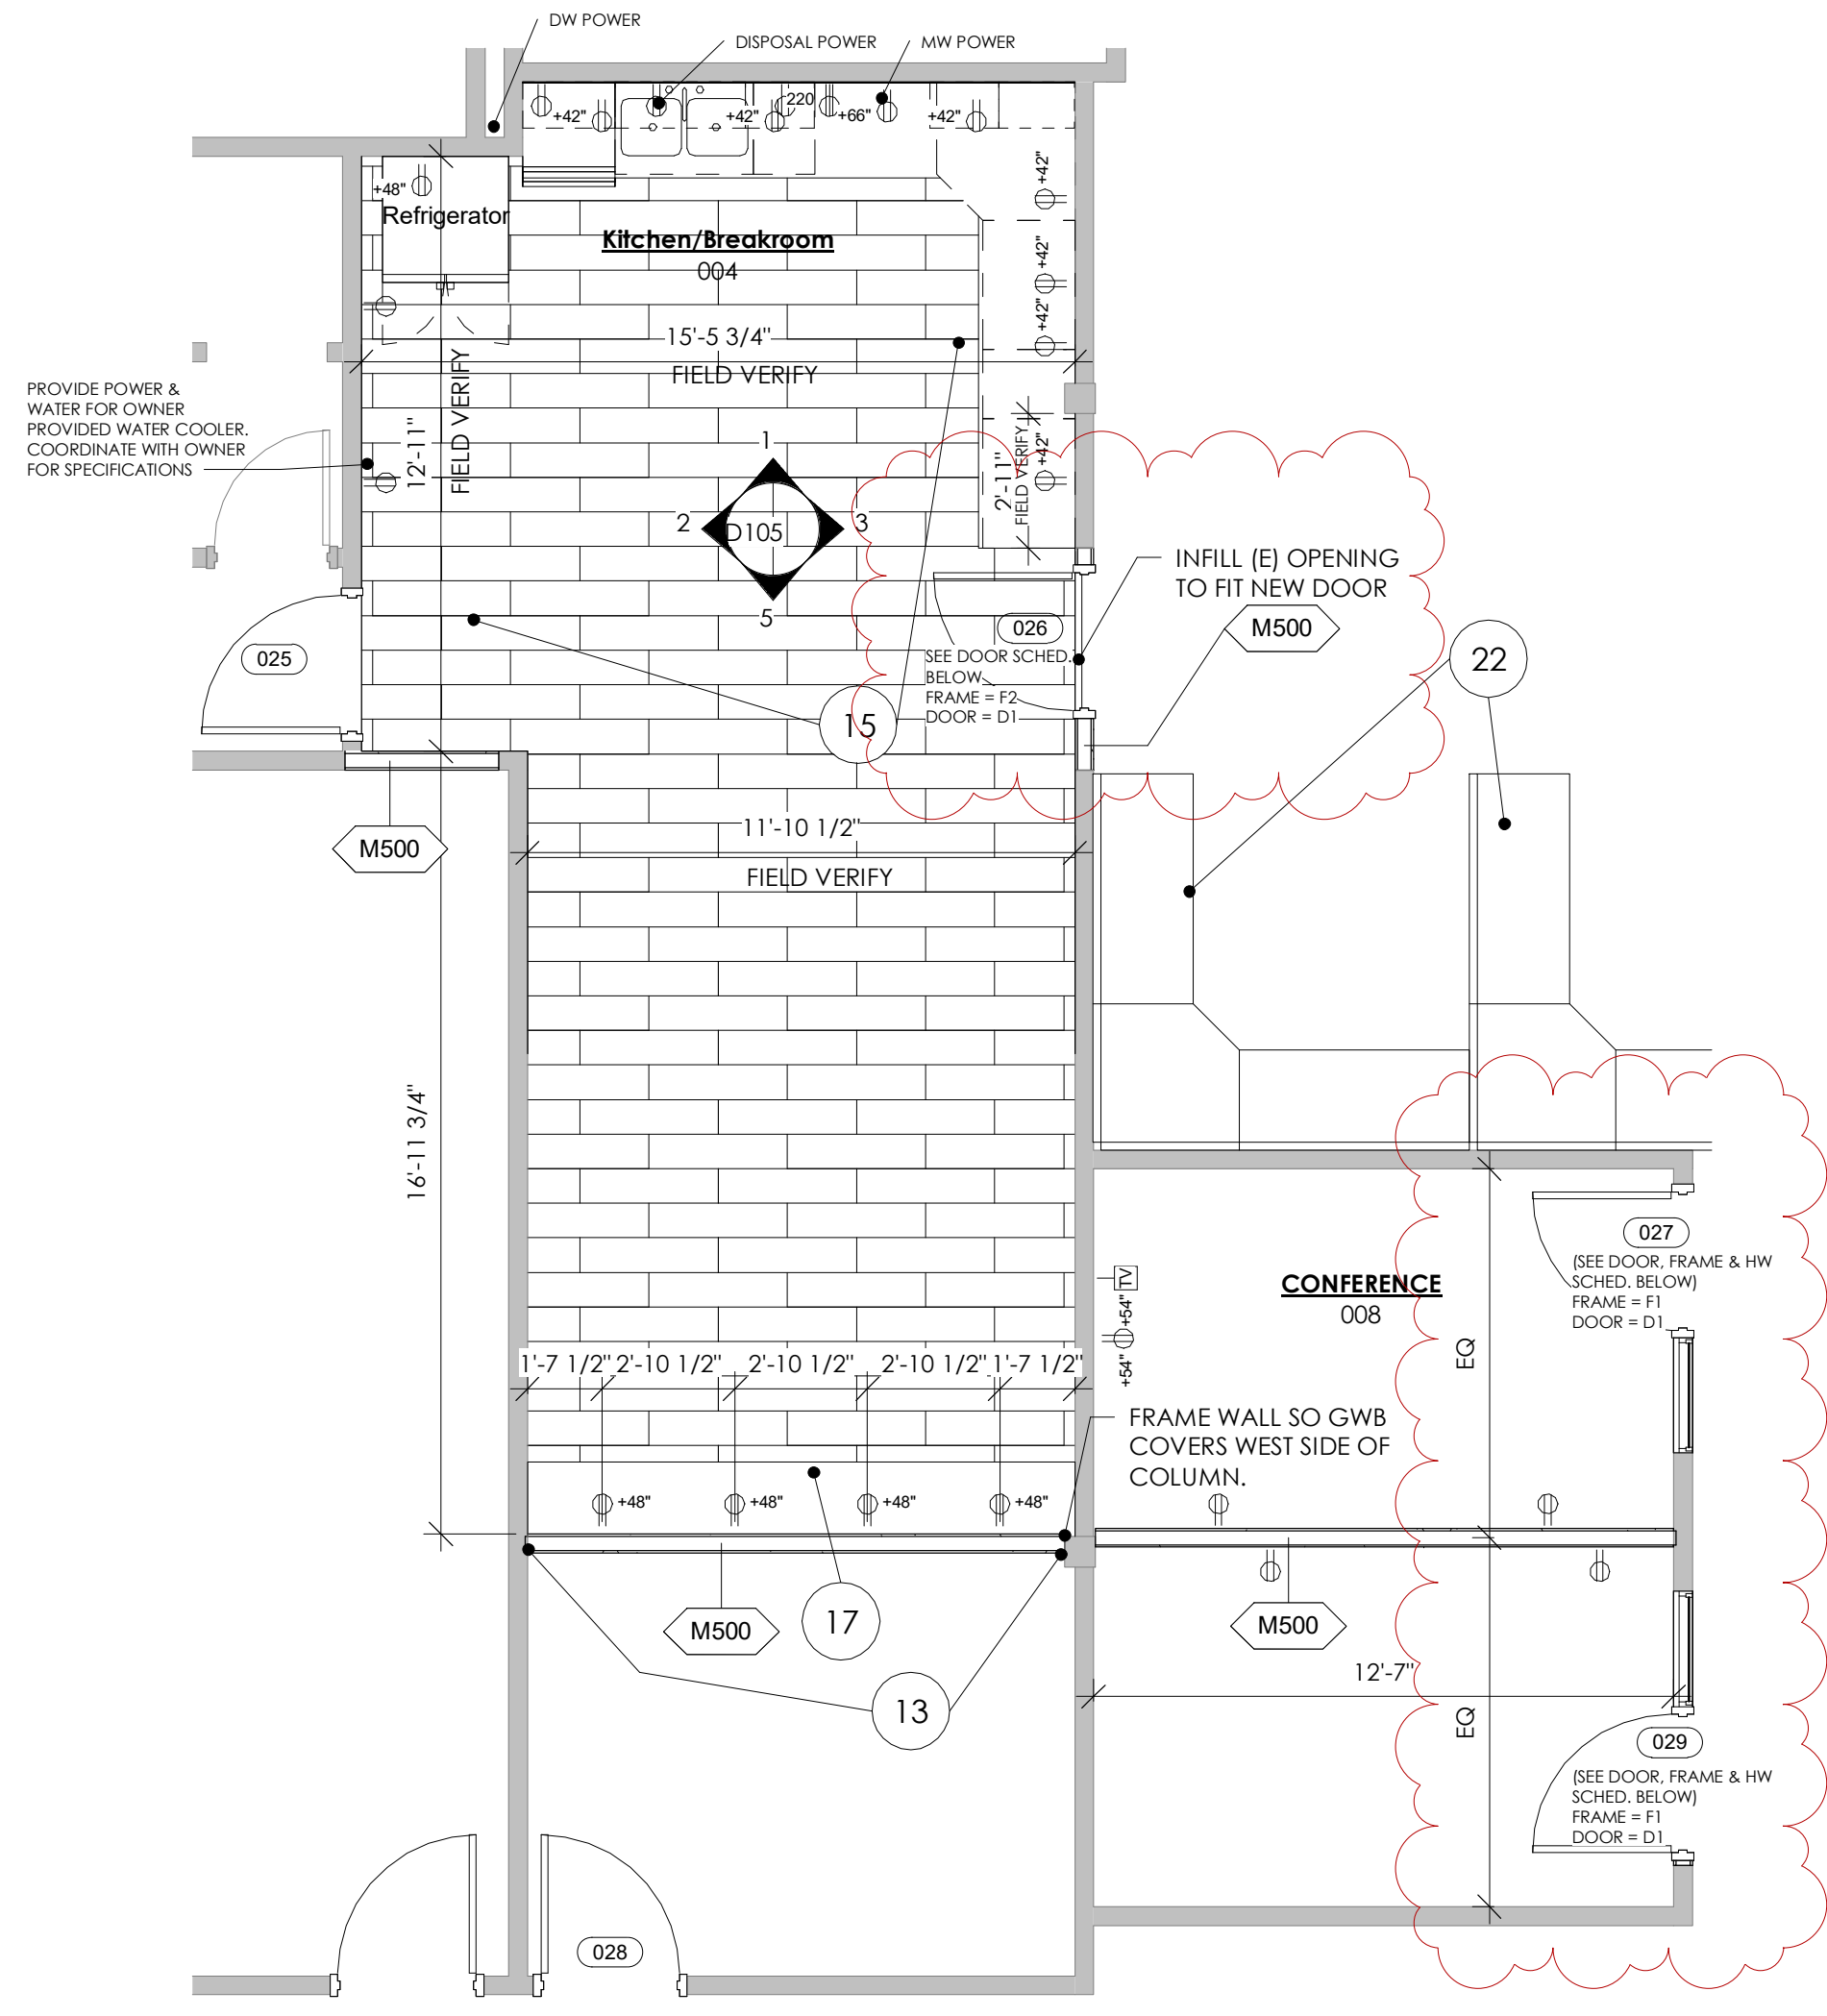


1 | BREAK ROOM PLAN
1/4" = 1'-0"

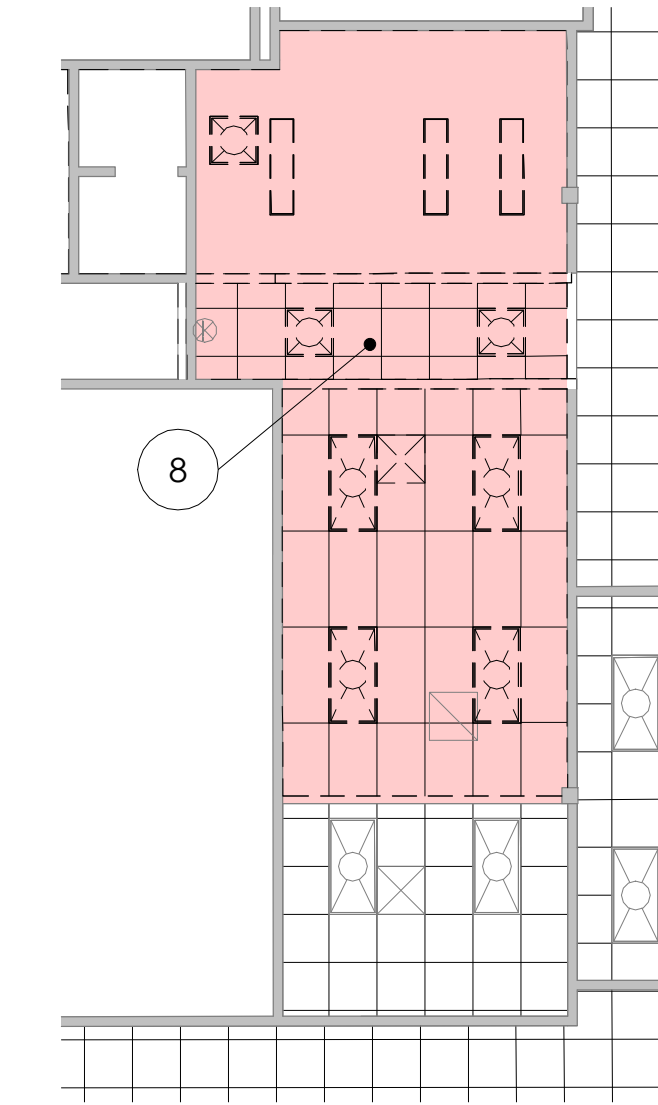

2 | BREAK ROOM DEMOLITION REFLECTED CEILING PLAN
1/8" = 1'-0"

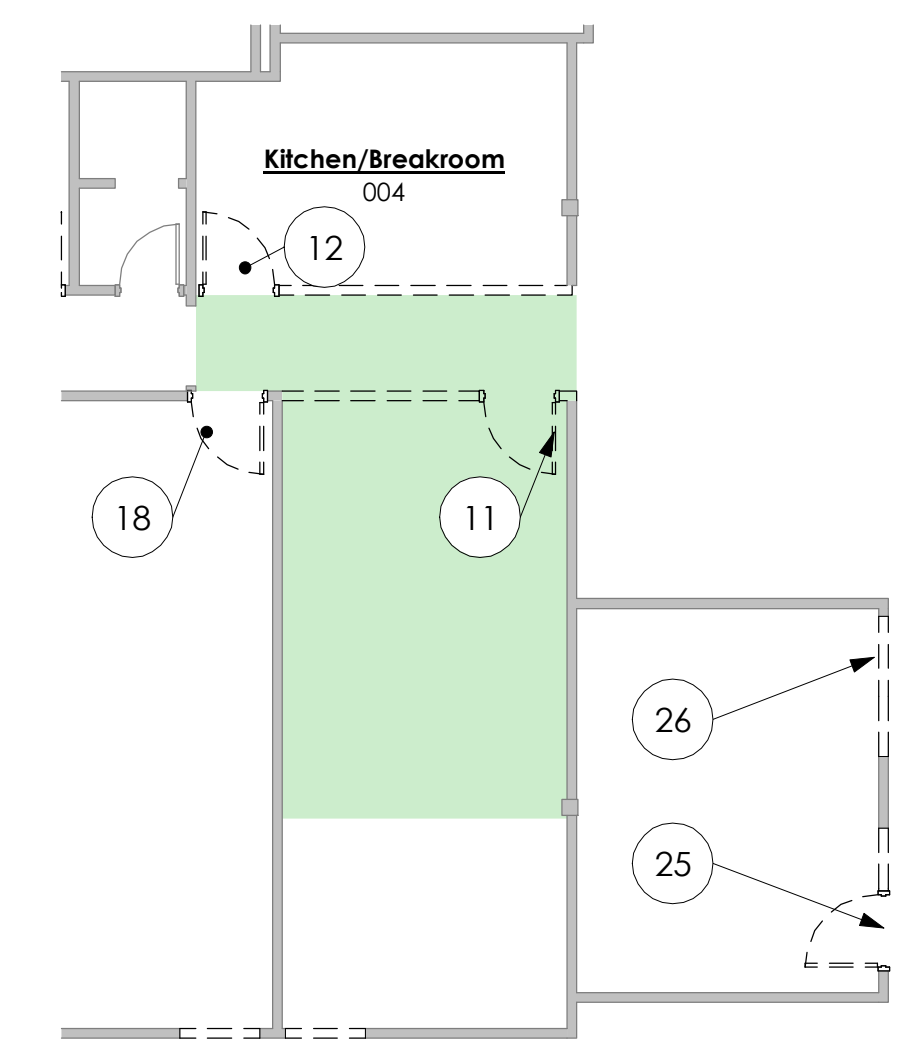

4 | BREAKROOM DEMOLITION PLAN
1/8" = 1'-0"

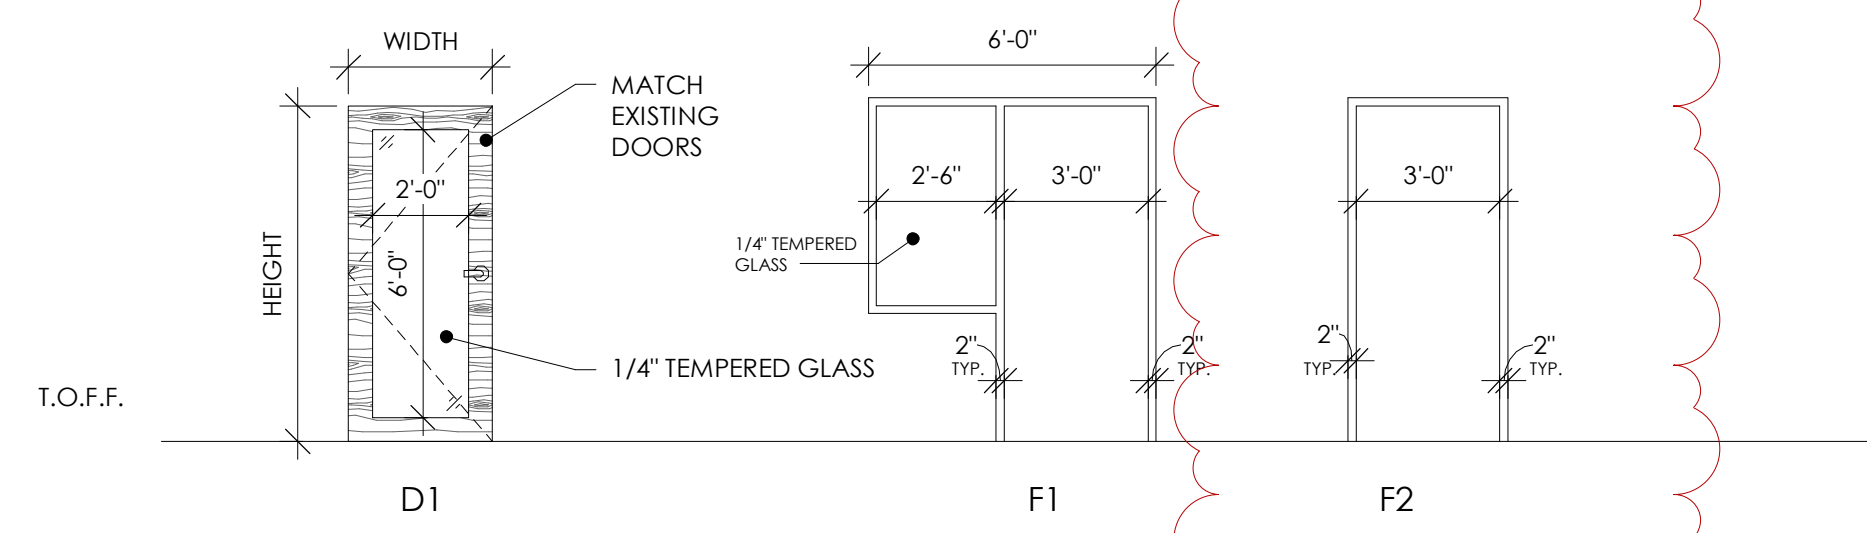

- GROUP B (PASSAGE LOCKSET)
1.5 BUTTS
1.0 PASSAGE LEVER
1.0 WALL DOORSTOP
- TRUDOOR
SCHLAGE
ASSA ABLOY
- BB-NRP
ALX10 LAT
ROCKWOOD 409

LEGEND

- DEMOLITION**
- EXISTING WALLS TO REMAIN
 - DEMOLISHED WALLS/FIXTURES
 - AREA OF DEMOLITION
 - REMOVE CARPET/VCT & BASE
 - REMOVE CEILING TILES, LIGHTS, AND DIFFUSERS - LEAVE GRID

BREAKROOM PLANS

SCALE: As Indicated

D102

DRAWN BY: Author

