

**Addendum No. 03****Issued: March 14, 2025**

Project Name: Brighton High School Teen Center
Project No.: 2024516
Bid Document Date: March 1, 2025
Bid Package: NA
Owner Name: Canyons School District

This addendum is issued to all bidders for the Construction Contract for the above referenced project.

This addendum serves to clarify, revise or supersede information in the Project Manual, the Drawings and if applicable, previously issued Addenda. All bidders submitting proposals on the above project shall be governed by the following changes and shall acknowledge receipt of this Addendum on the Bid form.

The date for receipt of the bids is unchanged by this Addendum.

A. Changes to the Project Manual

Changes to attached specification sections are indicated in red text with deleted text, if applicable, removed from the section.

DIVISIONS 00 through 14**A3.1 Section 064100 – Architectural Wood Casework**

- Per Bid question, Cabinetry thicknesses have been clarified as noted in **RED** on the specification section.

ARCHITECTURAL**A3.2 Sheet AD101**

- Demo sheet has been updated for removal of wall between prep area and storage space as noted.

A3.3 Sheet A101

- Wall between spaced to be turned into framed opening as shown. Cased opening height @ 8'-0" AFF. Door opening to be framed and finished to match adjacent space.

A3.4 Sheet A600

- Door E106 to be removed and reused from existing restroom, hardware to be reused from door being removed (E104) and reused on E106.

A3.5 Sheet A651

- Finishes have been clarified for replacement of the door and transition between spaces.

MECHANICAL

A3.6 Sheets M101, MP101, P101, FP101

- Backgrounds have been updated to reflect room updates

ELECTRICAL

A3.7 Sheet ED101

- Demolition plan has been updated

A3.8 Sheet E201

- Lighting Plan has been updated

A3.9 Sheet E301

- Electrical Floor plan has been updated.

Attachments:

Project Manual:

Section 064100 – Architectural Wood Casework

Drawings:

Sheets AD101, A101, A600, A651, M101, MP101, P101, ED101, E201, E301, FP101.

END OF ADDENDUM

SECTION 064100 - ARCHITECTURAL WOOD CASEWORK

PART 1 GENERAL

1.01 SECTION INCLUDES

- A. Specially fabricated cabinet units.
- B. Hardware.
- C. Preparation for installing utilities.

1.02 RELATED REQUIREMENTS

- A. Section 123600 - Countertops.

1.03 ADMINISTRATIVE REQUIREMENTS

- A. Preinstallation Meeting: Convene a preinstallation meeting not less than one week before starting work of this section; require attendance by all affected installers.

1.04 SUBMITTALS

- A. See Section 013000 - Administrative Requirements for submittal procedures.
- B. Shop Drawings: Indicate materials, component profiles, fastening methods, jointing details, and accessories.
 - 1. Scale of Drawings: 1-1/2 inch to 1 foot, minimum.
 - 2. Provide information as required by AWI/AWMAC/WI (AWS) or AWMAC/WI (NAAWS).
- C. Product Data: Provide data for hardware accessories.
- D. Samples: Submit actual samples of architectural cabinet construction, minimum 12 inches square, illustrating proposed cabinet, countertop, and shelf unit substrate and finish.
- E. Samples: Submit actual sample items of proposed pulls, hinges, shelf standards, and locksets, demonstrating hardware design, quality, and finish.

1.05 QUALITY ASSURANCE

- A. Fabricator Qualifications: Company specializing in fabricating the products specified in this section with minimum five years of documented experience.
 - 1. Company with at least one project in the past 5 years with value of woodwork within 20 percent of cost of woodwork for this Project.
 - 2. Single Source Responsibility: Provide and install this work from single fabricator.

1.06 MOCK-UPS

- A. Provide mock-up of typical base cabinet, wall cabinet, and countertop, including hardware, finishes, and plumbing accessories.

- B. Locate where directed.
- C. Mock-up may remain as part of the work.

1.07 DELIVERY, STORAGE, AND HANDLING

- A. Protect units from moisture damage.

1.08 FIELD CONDITIONS

- A. During and after installation of custom cabinets, maintain temperature and humidity conditions in building spaces at same levels planned for occupancy.

PART 2 PRODUCTS

2.01 FABRICATORS

- A. Provide architectural woodwork by one of the following:
 - 1. Artistic Mill.
 - 2. Granite Mill and Fixture Company.
 - 3. Huetter Mill and Cabinet Company.
 - 4. Johnson Brothers, Inc.
 - 5. MapleLeaf Cabinets.
 - 6. Swainston Mill, Preston ID.
 - 7. TMI Systems.
- B. Substitutions: See Section 016000 - Product Requirements.

2.02 CABINETS

- A. Quality Standard: Premium Grade, in accordance with AWI/AWMAC/WI (AWS) or AWMAC/WI (NAAWS), unless noted otherwise.
- B. Cabinets:
 - 1. Finish - Exposed Exterior Surfaces: Decorative laminate.
 - 2. Finish - Exposed Interior Surfaces: Decorative laminate.
 - 3. Finish - Semi-Exposed Surfaces: TFL Panels.
 - 4. Finish - Concealed Surfaces: Manufacturer's option.
 - 5. Door and Drawer Front Edge Profiles: Square, with PVC edge banding.
 - 6. Casework Construction Type: Type A - Frameless.
 - 7. Interface Style for Cabinet and Door: Style 1 - Overlay; flush overlay.
 - 8. Cabinet Design Series: As indicated on drawings.
 - 9. Adjustable Shelf Loading: 50 psf.
 - 10. Drawer Construction Technique: Dovetail joints.

2.03 PANEL CORE MATERIALS

- A. Medium Density Fiberboard (MDF): Composite panel composed of cellulosic fibers, additives, and bonding system; cured under heat and pressure; comply with ANSI A208.2.
 - 1. Grade: 140; moisture resistance: MR30.
 - 2. Panel Thickness:

- a. Case Body and Doors: 3/4 inch.
 - b. Case Tops and Bottoms: 3/4 inch, except 1 inch at bottoms of wall units.
 - c. Exposed Backs: 1/2 inch.
 - d. Drawer Sides, Backs and Sub-Fronts: 1/2 inch.
 - e. Drawer Fronts: 3/4 inch.
 3. Panel Thickness - Shelves: 1 inch at 36 inches and less; 1-1/4 inch over 36 inches.
 4. Products:
 - a. Roseburg Forest Products; Medite II: www.roseburg.com/#sle.
 - b. Substitutions: See Section 016000 - Product Requirements.
- B. Basic Hardboard: Panel manufactured from inter-felted lignocellulosic fibers consolidated under heat and pressure; comply with ANSI A135.4.
1. Class: Tempered.
 2. Surface: Smooth one side (S1S).
 3. Nominal Thickness: 1/4 inch.

2.04 THERMALLY FUSED LAMINATE PANELS

- A. Thermally Fused Laminate (TFL): Melamine- or polyester-resin-saturated decorative papers; for fusion to composite wood substrates under heat and pressure.
1. Test in accordance with NEMA LD 3 Section 3.
 2. Panel Core Substrate: Medium Density Fiberboard (MDF).
 3. Color: As selected from manufacturer's standard range of colors.

2.05 LAMINATE MATERIALS

- A. Manufacturers:
1. Arborite: www.arborite.com/#sle.
 2. Formica Corporation: www.formica.com/#sle.
 3. Panolam Industries International, Inc: www.panolam.com/#sle.
 4. Wilsonart LLC: www.wilsonart.com/#sle.
 5. Substitutions: See Section 016000 - Product Requirements.
- B. Provide specific types as follows:
1. Horizontal Surfaces: HGS, 0.048 inch nominal thickness, colors as indicated.
 2. Vertical Surfaces: VGS, 0.028 inch nominal thickness, colors as indicated.
 3. Laminate Backer: BKL, 0.020 inch nominal thickness, undecorated; for application to concealed backside of panels faced with high pressure decorative laminate.

2.06 COUNTERTOPS

- A. Countertops: See Section 123600.

2.07 ACCESSORIES

- A. Adhesive: Type recommended by fabricator to suit application.
- B. Plastic Edge Banding: Extruded PVC, flat shaped; smooth finish; self locking serrated tongue; of width to match component thickness.
1. Thickness: 3 mm.
 2. Color: As selected by Architect from manufacturer's standard range.

- C. Fasteners: Size and type to suit application.
- D. Bolts, Nuts, Washers, Lags, Pins, and Screws: Of size and type to suit application; galvanized or chrome-plated finish in concealed locations and stainless steel or chrome-plated finish in exposed locations.

2.08 HARDWARE

- A. Adjustable Shelf Supports at Casework: Standard side-mounted system using multiple holes for pin supports and coordinated self rests, polished chrome finish, for nominal 1 inch spacing adjustments.
 - 1. Product: Knape & Vogt, 346.
 - 2. Substitutions: See Section 016000 - Product Requirements.
- B. Adjustable Shelf Supports at Wall Mounted Shelving: Heavy duty double slot system using surface mounted metal shelf standards and coordinated cantilevered shelf brackets, satin chrome finish, for nominal 1 inch spacing adjustments.
 - 1. Products:
 - a. Shelf Brackets: Knape & Vogt; 185 double slot.
 - b. Shelf Standards: Knape & Vogt; 185.
 - 2. Substitutions: See Section 016000 - Product Requirements.
- C. Countertop Brackets: Fixed, concealed vertical leg, side-of-stud mounting.
 - 1. Materials: Steel L- and T-shapes.
 - a. Finish: Manufacturer's standard, factory-applied, powder coat.
 - b. Color: Black.
 - c. Support Member Depth: 2 inches.
 - d. Support Member Width: 2 inches.
 - e. Support Member Length: 21 inches.
 - 2. Products:
 - a. A&M Hardware, Inc; Extended Concealed Brackets: www.aandmhardware.com/#sle.
 - b. Substitutions: See Section 016000 - Product Requirements.
- D. Drawer and Door Pulls: .
- E. Basis-of Design: Top Knobs; Europa Tab Pull: www.topknobs.com/collections/#sle.
 - 1. Size: 5 inch.
 - 2. Finish: Brushed satin nickel.
- F. Drawer and Door Locks: 5-pin tumbler, complying with ANSI/BHMA A156.11, Grade 1
 - 1. Keyed cylinder, two keys per lock, master keyed according to Owner's key schedule.
 - 2. Olympus Lock, Inc. or comparable.
 - a. Finish: Satin Chrome: 26D.
 - b. Drawer Locks: 200W.
 - c. Door Locks: 100DR.
 - 3. Substitutions: See Section 016000 - Product Requirements.
- G. Drawer Slides:
 - 1. Type: Full extension.
 - 2. Static Load Capacity: Heavy Duty grade.
 - 3. Manufacturers:
 - a. Accuride International, Inc; Heavy-Duty Drawer Slides: www.accuride.com/#sle.
 - b. Blum, Inc; MOVENTO: www.blum.com/#sle.

- c. Hettich America, LP; Quadro: www.hettich.com/#sle.
 - d. Substitutions: See Section 016000 - Product Requirements.
- H. Hinges: European style concealed self-closing type, steel with nickel-plated finish.
- 1. Manufacturers:
 - a. Blum, Inc; CLIP top BLUMOTION: www.blum.com/#sle; 155 degree opening.
 - b. Substitutions: See Section 016000 - Product Requirements.

2.09 FABRICATION

- A. Assembly: Shop assemble cabinets for delivery to site in units easily handled and to permit passage through building openings.
- B. Edging: Fit shelves, doors, and exposed edges with specified edging. Do not use more than one piece for any single length.
- C. Fitting: When necessary to cut and fit on site, provide materials with ample allowance for cutting. Provide matching trim for scribing and site cutting.
- D. Plastic Laminate: Apply plastic laminate finish in full uninterrupted sheets consistent with manufactured sizes. Fit corners and joints hairline; secure with concealed fasteners. Slightly bevel arises. Locate counter butt joints minimum 2 feet from sink cut-outs.
 - 1. Apply laminate backing sheet to reverse side of plastic laminate finished surfaces.
 - 2. Cap exposed plastic laminate finish edges with material of same finish and pattern.
- E. Mechanically fasten back splash to countertops as recommended by laminate manufacturer at 16 inches on center.
- F. Provide cutouts for plumbing fixtures. Verify locations of cutouts from on-site dimensions. Prime paint cut edges.

PART 3 EXECUTION

3.01 EXAMINATION

- A. Verify adequacy of backing and support framing.
- B. Verify location and sizes of utility rough-in associated with work of this section.

3.02 INSTALLATION

- A. Install work in accordance with AWI/AWMAC/WI (AWS) or AWMAC/WI (NAAWS) requirements for grade indicated.
- B. Set and secure custom cabinets in place, assuring that they are rigid, plumb, and level.
- C. Use fixture attachments in concealed locations for wall mounted components.
- D. Use concealed joint fasteners to align and secure adjoining cabinet units.
- E. Carefully scribe casework abutting other components, with maximum gaps of 1/32 inch. Do not use additional overlay trim for this purpose.
- F. Secure cabinets to floor using appropriate angles and anchorages.


3.03 ADJUSTING

- A. Adjust installed work.
- B. Adjust moving or operating parts to function smoothly and correctly.


3.04 CLEANING

- A. Clean casework, counters, shelves, hardware, fittings, and fixtures.

END OF SECTION

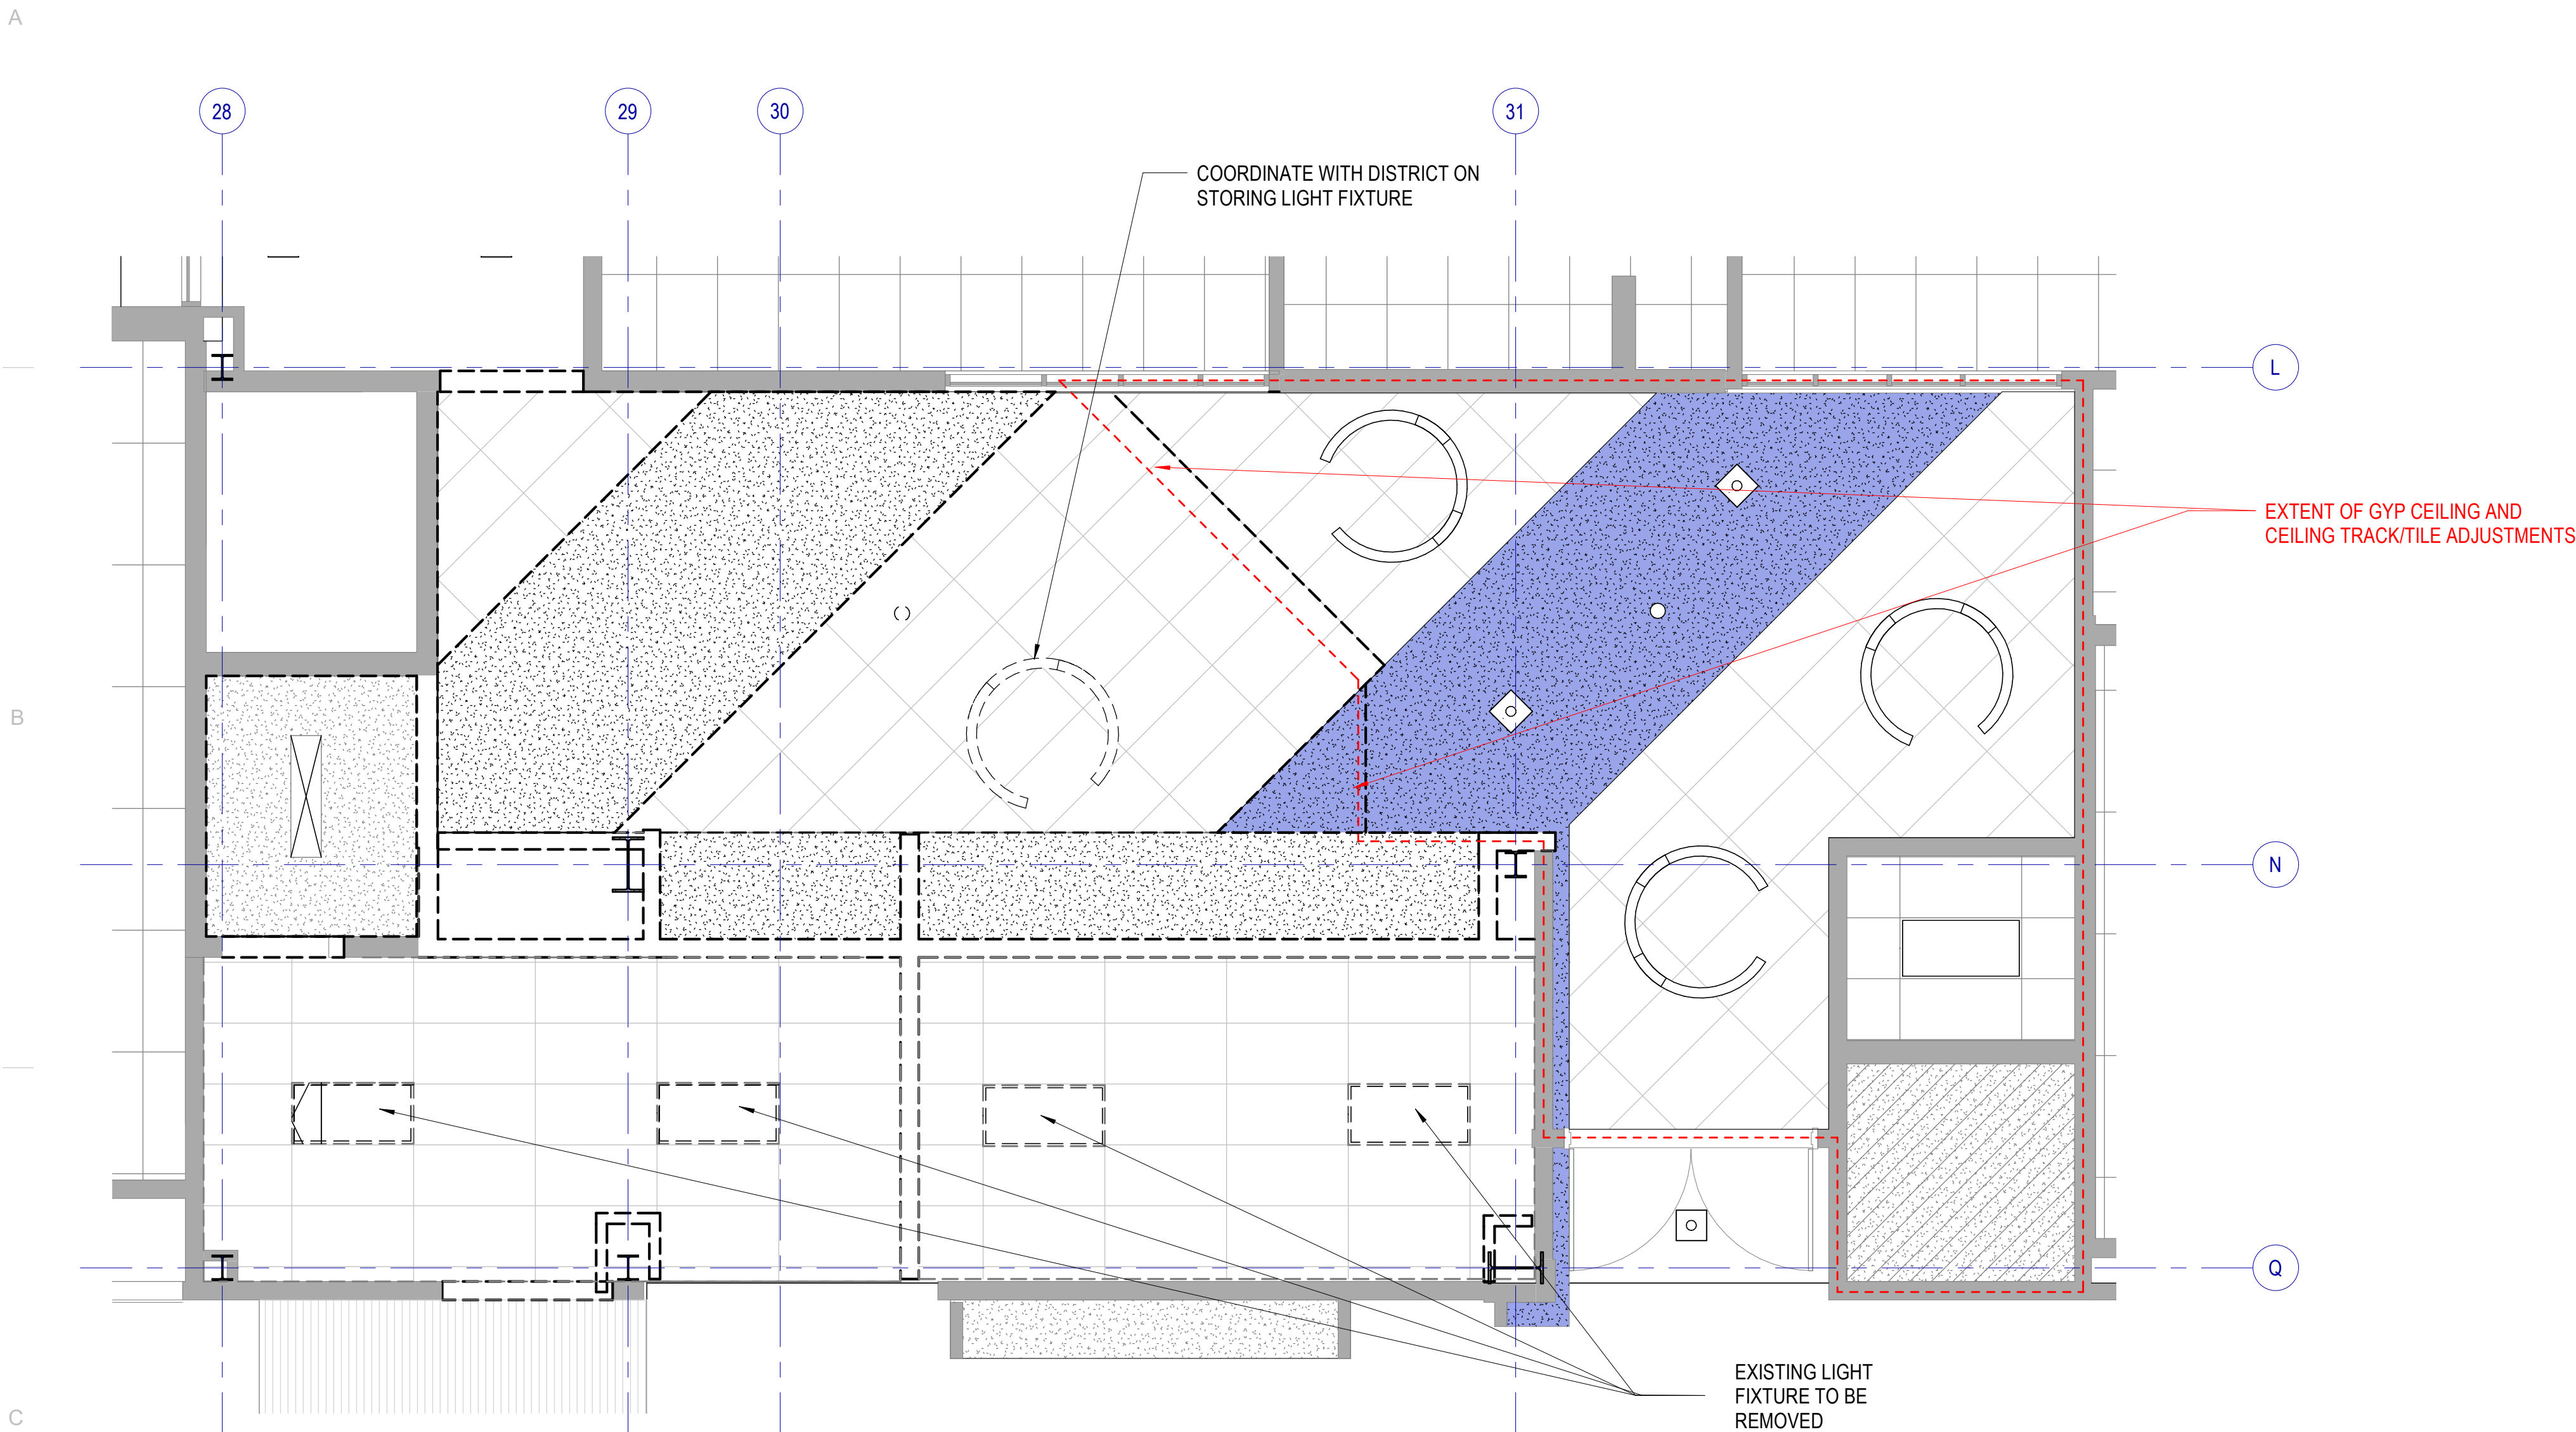

C1 DEMO FIRST FLOOR REFLECTED CEILING PLAN
SCALE: 1/4" = 1'-0"

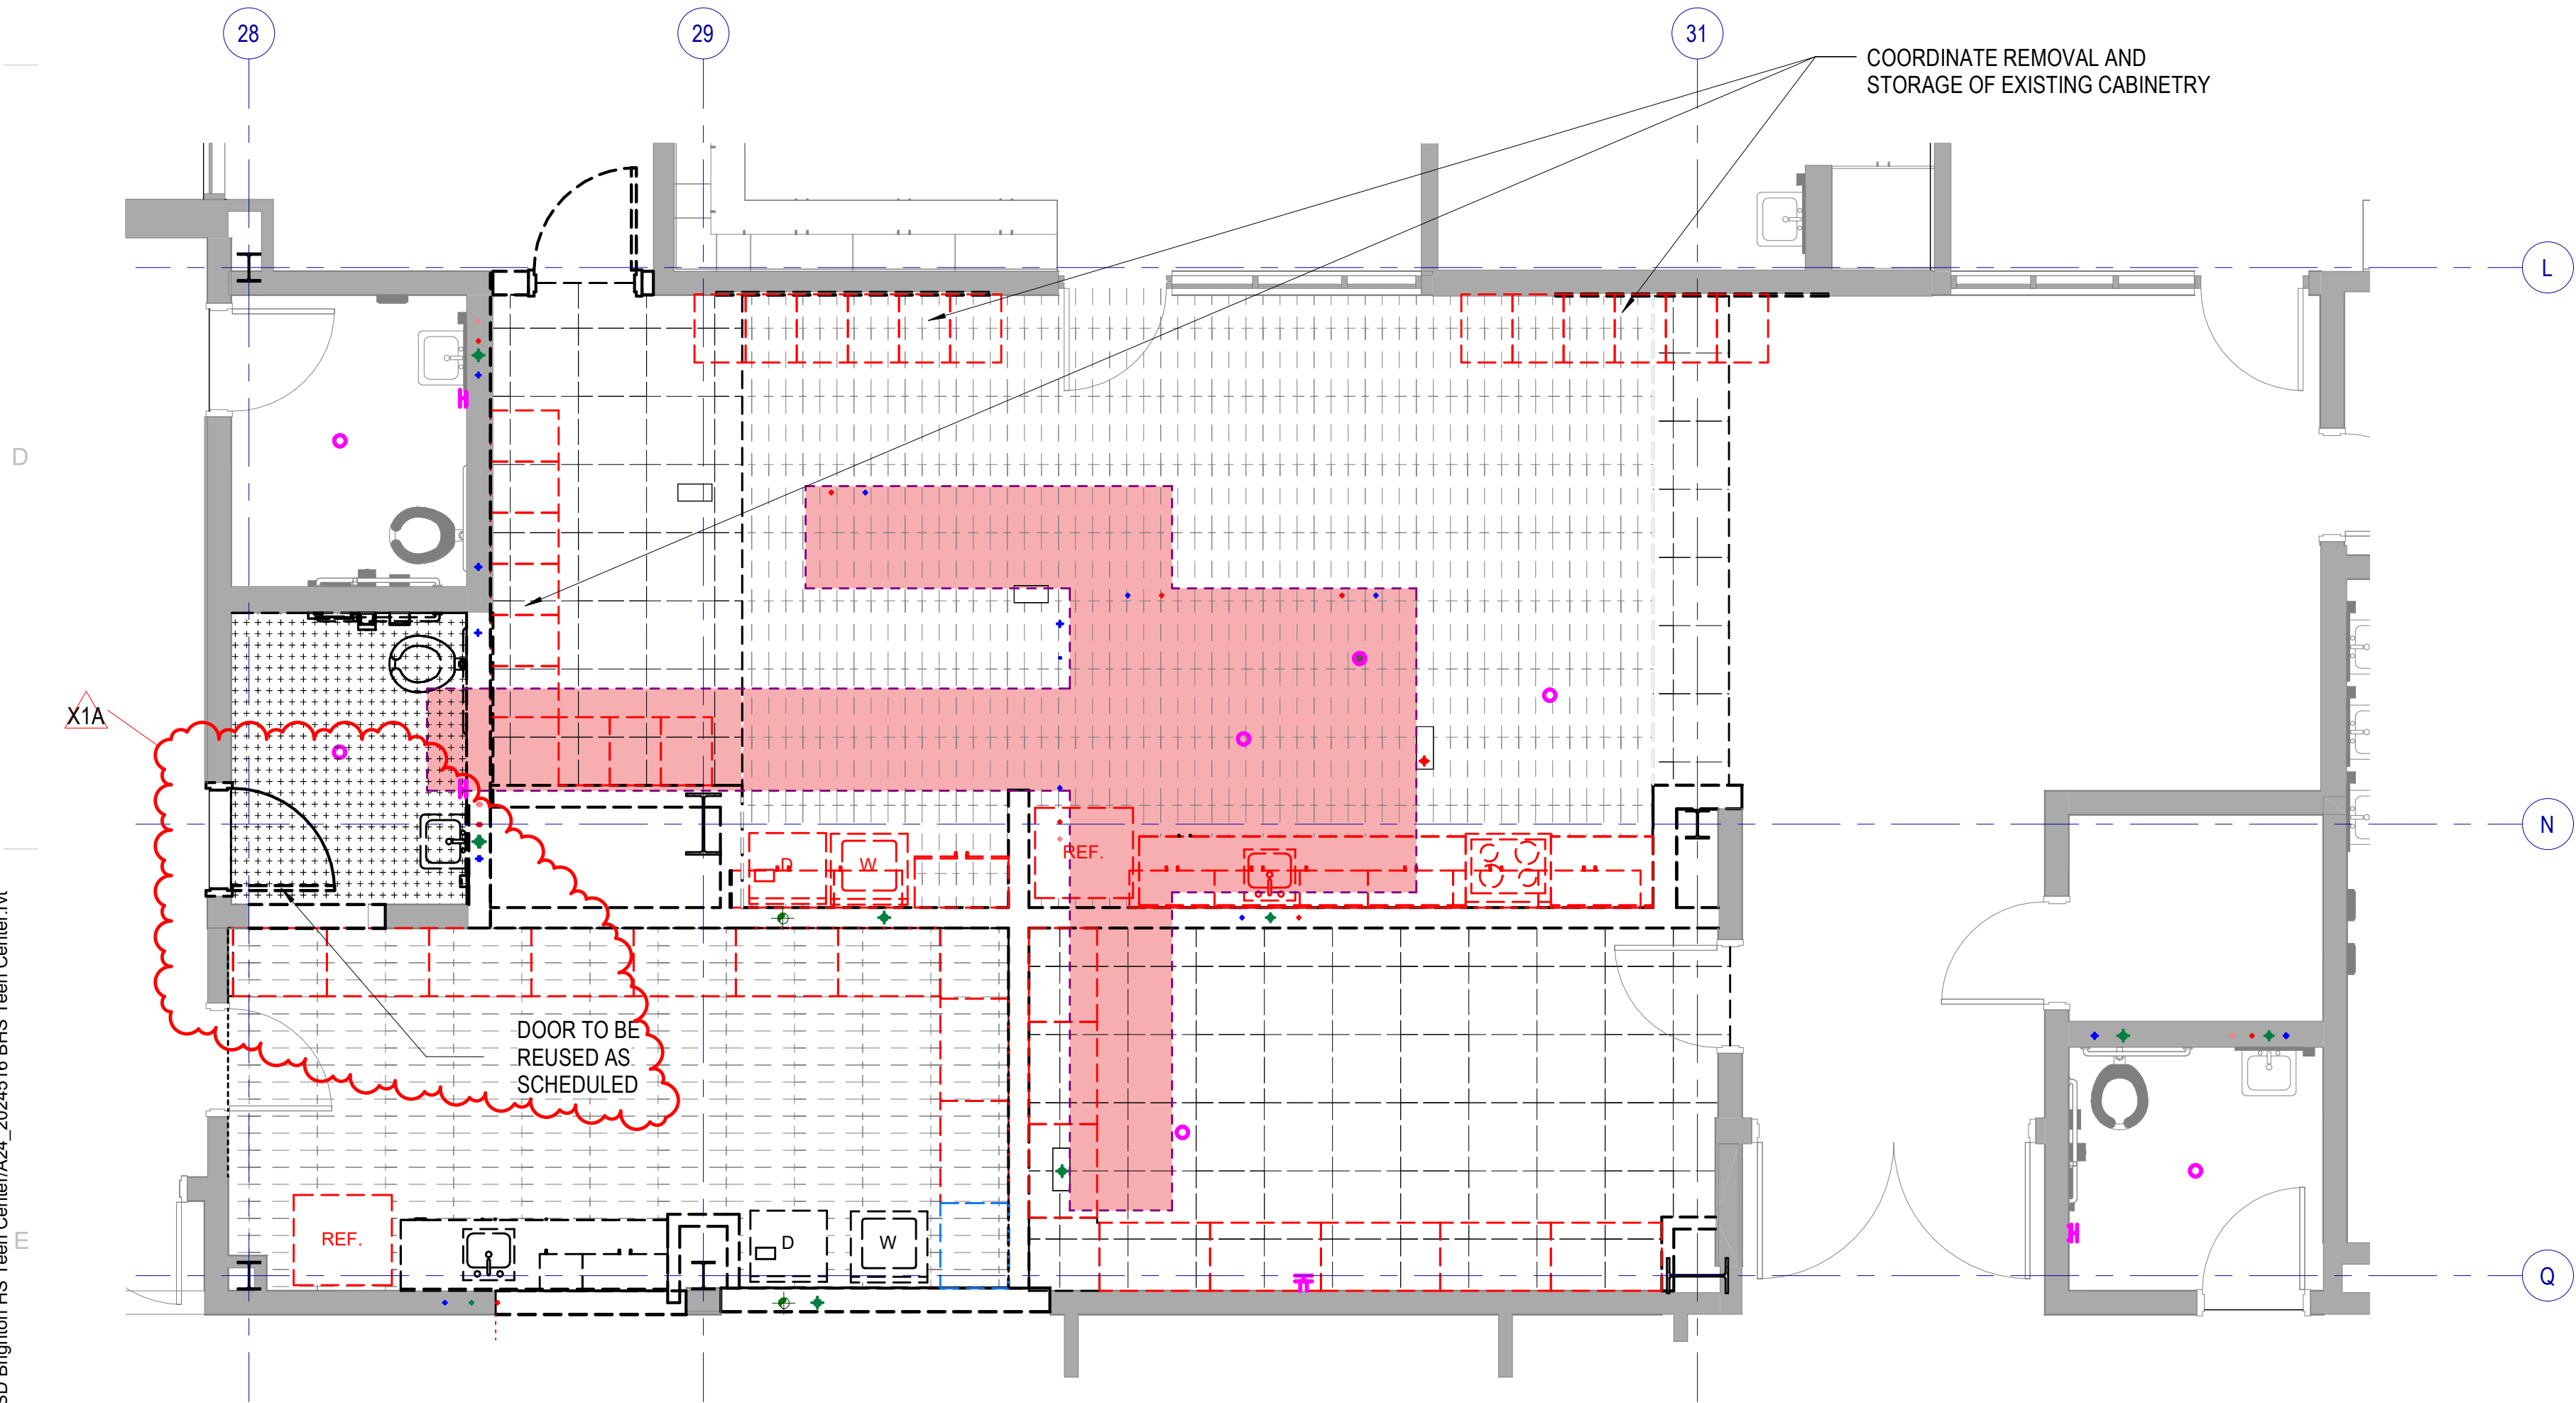

E1 DEMOLITION FIRST FLOOR PLAN
SCALE: 1/4" = 1'-0"

Autodesk Docs (2024516) CSD Brighton HS Teen Center/AD101_2024516 BHS Teen Center.rvt
3/14/2025 12:33:15 PM

DEMOLITION GENERAL NOTES

Existing Conditions: Verify existing site and building conditions including but not limited to underground utilities and service lines, irrigation lines, sub-surface structures and all other existing construction both above and below grade.

Protection: Protect existing construction to remain from damage during demolition and new construction work. Repair any damage resulting from this work.

Protect in-place, existing mechanical, plumbing and electrical systems above ceilings that are not shown to be removed. This includes, but is not limited to: network cabling, coax cabling, conduits, piping, ductwork, etc.

When removing concrete slabs on grade, take all necessary precautions to protect electrical lines in or under those slabs.

Site Access: Coordinate phased access to the site with the Owner, including times of restricted access.

Coordination: Coordinate extent of walls to be removed with architectural floor plan(s).

Masonry Walls: Where masonry walls are demolished, clean and repair newly exposed surfaces to match adjacent wall finish.

Salvage: Review with the owner, casework, furniture, equipment and wall mounted display surfaces left behind after owner move out, that are not shown on drawings. Identify as either salvage or to be disposed of by contractor.

Where indicated to be removed, salvage whiteboards and tack boards for reuse, UNO.

Where indicated to be removed, salvage undamaged acoustical ceiling panels for use in repair, patching and modifications of existing ceilings. Use only in ceilings where panels match.

Verify that existing equipment that is to remain, to be salvaged or to be re-installed, is in working condition. Provide written documentation to the Owner for any items that are not in working condition before beginning work in the area.

LEGEND - DEMOLITION

- AREA OF NO WORK
- EXISTING TO REMAIN
- REMOVE DOOR & FRAME
- WALLS & OTHER ITEMS TO BE DEMOLISHED
- CABINETY / APPLIANCES / LIGHTING TO BE REUSED
- TILE TO BE DEMOLISHED
- CARPET TO BE DEMOLISHED
- LVT TO BE DEMOLISHED
- CONCRETE FLOOR TO BE DEMOLISHED

NOTE: WHERE WALLS AND OTHER ITEMS ARE SHOWN WITH DASHED LINES, WHETHER KEYNOTED OR NOT, REMOVE THESE ITEMS TO THE EXTENT INDICATED AND AS REQUIRED BY NEW CONSTRUCTION.

KEYNOTES

- 024100.A02 DOOR TO BE REUSED AS SCHEDULED
- 265140.A03 EXISTING LIGHT FIXTURE TO BE REMOVED

MHTN ARCHITECTS
MHTN Architects, Inc.
260 South 400 West
Suite 250
Salt Lake City, Utah 84101
Telephone (801) 595-6700
www.mhtn.com

CANYONS SCHOOL DISTRICT

Canyons School District
Brighton High School Teen Center
2220 BENGAL BLVD
COTTONWOOD HEIGHTS, UT 84121

ISSUED BY MHTN ARCHITECTS, INC.
Confidentiality Notice
This document is intended for use on the Project identified herein by individuals and companies involved in the design, permitting, bidding and construction of the Project. MHTN Architects, Inc. grants written rights to distribute and reproduce this document for this express purpose only. Distribution, printing or copying this document for purposes other than those indicated is strictly prohibited. If a digital copy of this document is received in error, please delete it.

SEAL

MHTN PROJECT NO. 2024516
VIEW AND PRINT THIS DRAWING IN COLOR
Original drawing is 36 x 42. Do not scale contents of this drawing.

REVISIONS:
CONTRACTOR TO VERIFY DRAWINGS IN FIELD USE REFLECT
LAST REVISION DATE

NO.	DATE	DESCRIPTION
X1A	03.14.25	BID ADD 3

ISSUE
BID DOCUMENTS
MARCH 1, 2025

SHEET NAME
DEMOLITION FLOOR PLAN

SHEET NUMBER
AD101

REFLECTED CEILING PLAN GENERAL NOTES

RE: A710 for typical suspended ceiling details, including seismic bracing.

Ceiling Height: 9'-0" UNO. Where floor height varies in a room, ceiling height is shown at the entry to the room, UNO.

Ceiling Grid/Panel Alignment: The design intent of the Reflected Ceiling Plans is center ceiling grids or acoustical panels between walls in both directions, or to center grids in one direction, panels in the other. If the grid does not comply with the design intent, then coordinate with Architect to adjust the ceiling layout prior to installation.

Seismic Design Category: D: Heavy-duty suspension system required / Refer to Structural / Refer to Specifications.

Seismic Bracing: Rigid bracing required at ceilings over 1,000 SF and at all ceilings with fire sprinklers and other penetrations.

Seismic Control Joints: Provide seismic control joints in suspended acoustical ceilings greater than 2,500 SF.

Control Joints: Provide control joints in gypsum board ceilings at 30'-0" max spacing. Coordinate locations with Architect to align joints with other elements in the ceilings or on the walls.

Exposed Elements: Paint exposed structure, pipe, conduit and HVAC duct at open ceilings and at open areas around ceiling clouds. Color: As selected by Architect.

Walls to Deck: Extend all walls to deck, including all components of the wall assembly, UNO.

Fire Sprinklers: Center sprinkler heads in acoustical panels; run in straight lines in orthogonal, rectangular spaces.

Electrical, Mechanical and other Devices: Center in acoustical panels. Coordinate feature lighting layout with Architect prior to rough-in.

Keynotes: Not all keynotes apply to this sheet.

LEGEND - REFLECTED CEILING PLANS

- ACP1 - 24" X 24" ACOUSTICAL CEILING PANEL
- ACP2 - 24" X 48" ACOUSTICAL CEILING PANEL (EXISTING) ADJUST AS SHOWN
- CG1 - 9WOOD CEILING 1100 CROSS PIECE GRILLE (B.O.D.)
- GB1 - PAINTED GYPSUM BOARD
- GB2 - EPOXY PAINTED GYPSUM BOARD
- GB3 - PAINTED TO MATCH EXISTING
- MECHANICAL DIFFUSERS
SEE MECHANICAL
- LIGHT FIXTURES
SEE ELECTRICAL

LEGEND - FLOOR PLAN

- FEC.R FIRE EXTINGUISHER + CABINET RECESSED
- CG STAINLESS STEEL CORNER GUARD
- FLOOR MOUNTED TOILET
RE: PLUMBING
- COUNTER MOUNTED SINK
RE: PLUMBING
- WASHER & DRYER, OFOI
- REF. REFRIGERATOR, OFOI
- EXISTING, RE-USED STOVE/RANGE

NOTE: PROVIDE ITEMS INDICATED IN THE LEGEND IN THE QUANTITIES SHOWN ON THE PLANS AND ELEVATIONS.

FLOOR PLAN GENERAL NOTES

References to sheets below are provided to aid in navigating the drawings.

RE: G200 for Fixture Mounting Heights.

RE: G500 for Interior Wall Types.

RE: G600 for typical details.

RE: A111 for slab edges, recesses and other transitions.

RE: A600 for the Door Schedule.


RE: A620 drawings for Window Types.

Rated Construction: Provide as shown on the plans, the Life Safety Plans and elsewhere in the documents. Seal penetrations with systems applicable to the application and that have UL or other testing agency certifications.

Keynotes: Not all keynotes apply to this sheet.


KEYNOTES

- 024100.A01 EXISTING SPED CUBBIES, REUSED
- 064023.C01 PLASTIC LAMINATED FLOATING SHELF WITH INTEGRAL SUPPORTS
- 064023.F01 WALL MOUNTED, 3/4" PLASTIC LAMINATE ADJUSTABLE SHELVING W/ EDGE BANDING
- 102800.F01 DIAPER-CHANGING STATION, OFOI
- 112300.A04 EXISTING WASHING MACHINE AND DRYER
- NOTE 1 ALIGN FINISHES TO EXISTING FINISHES

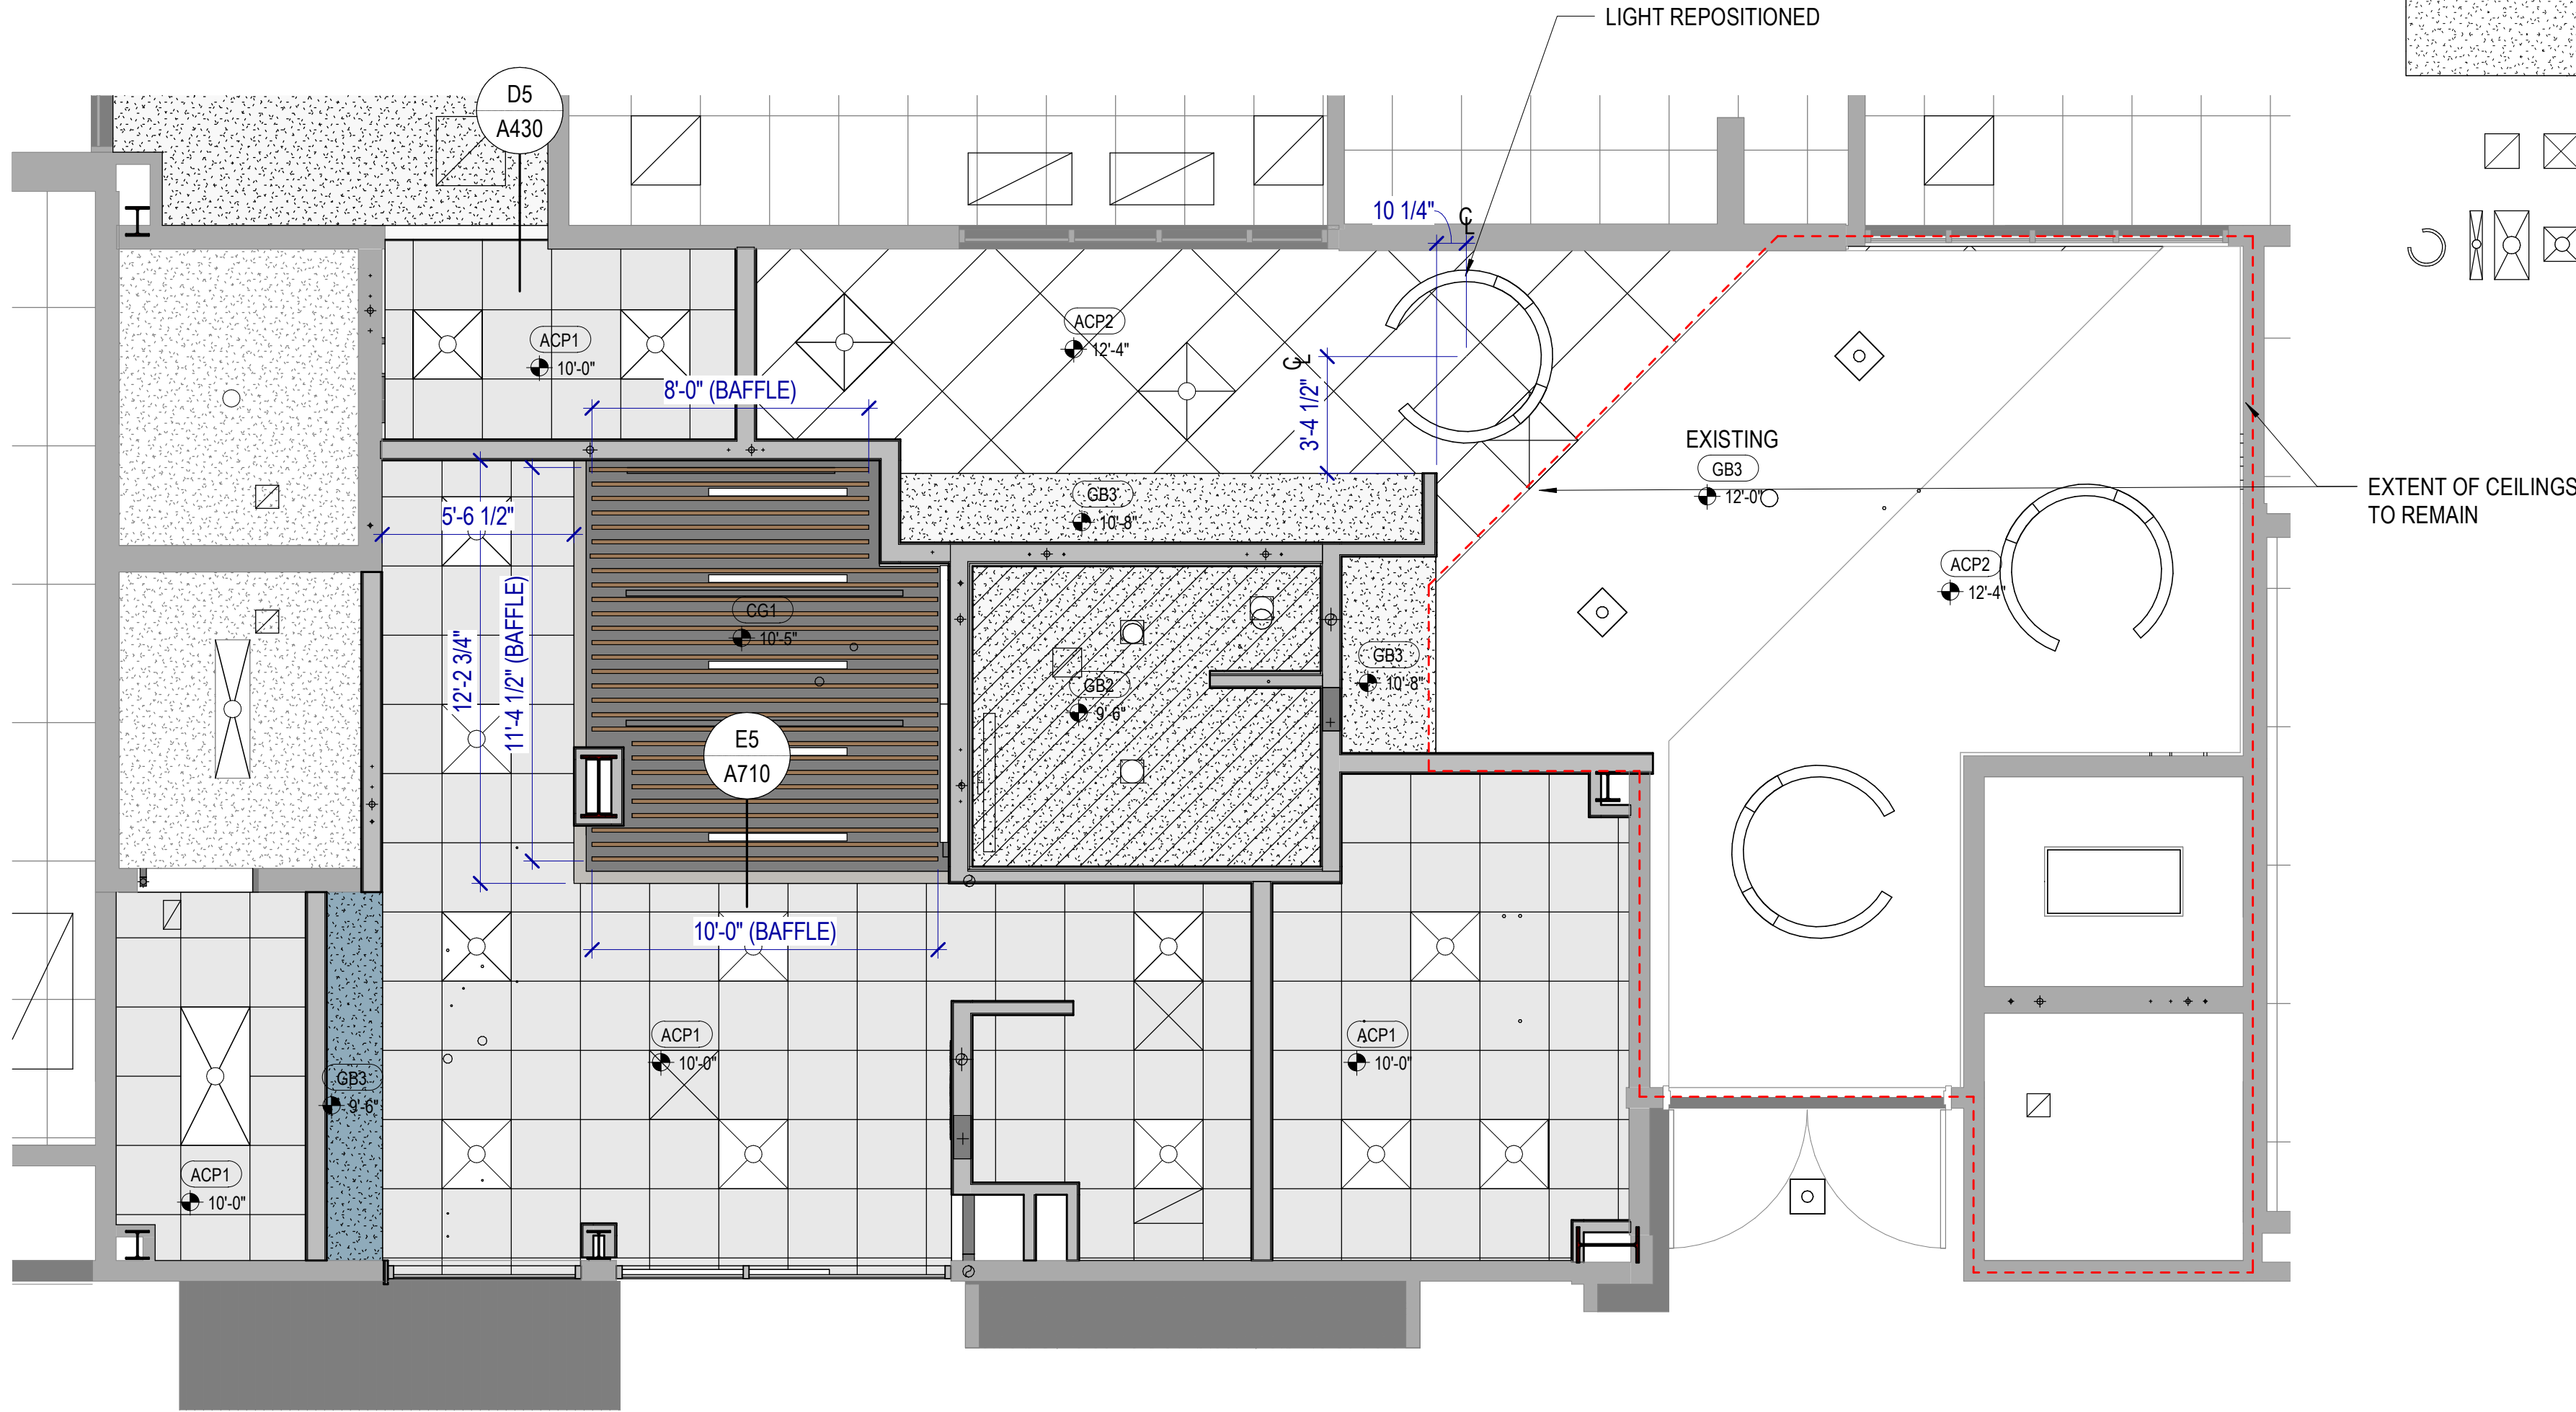


C1 FIRST FLOOR REFLECTED CEILING PLAN

SCALE: 1/4" = 1'-0"

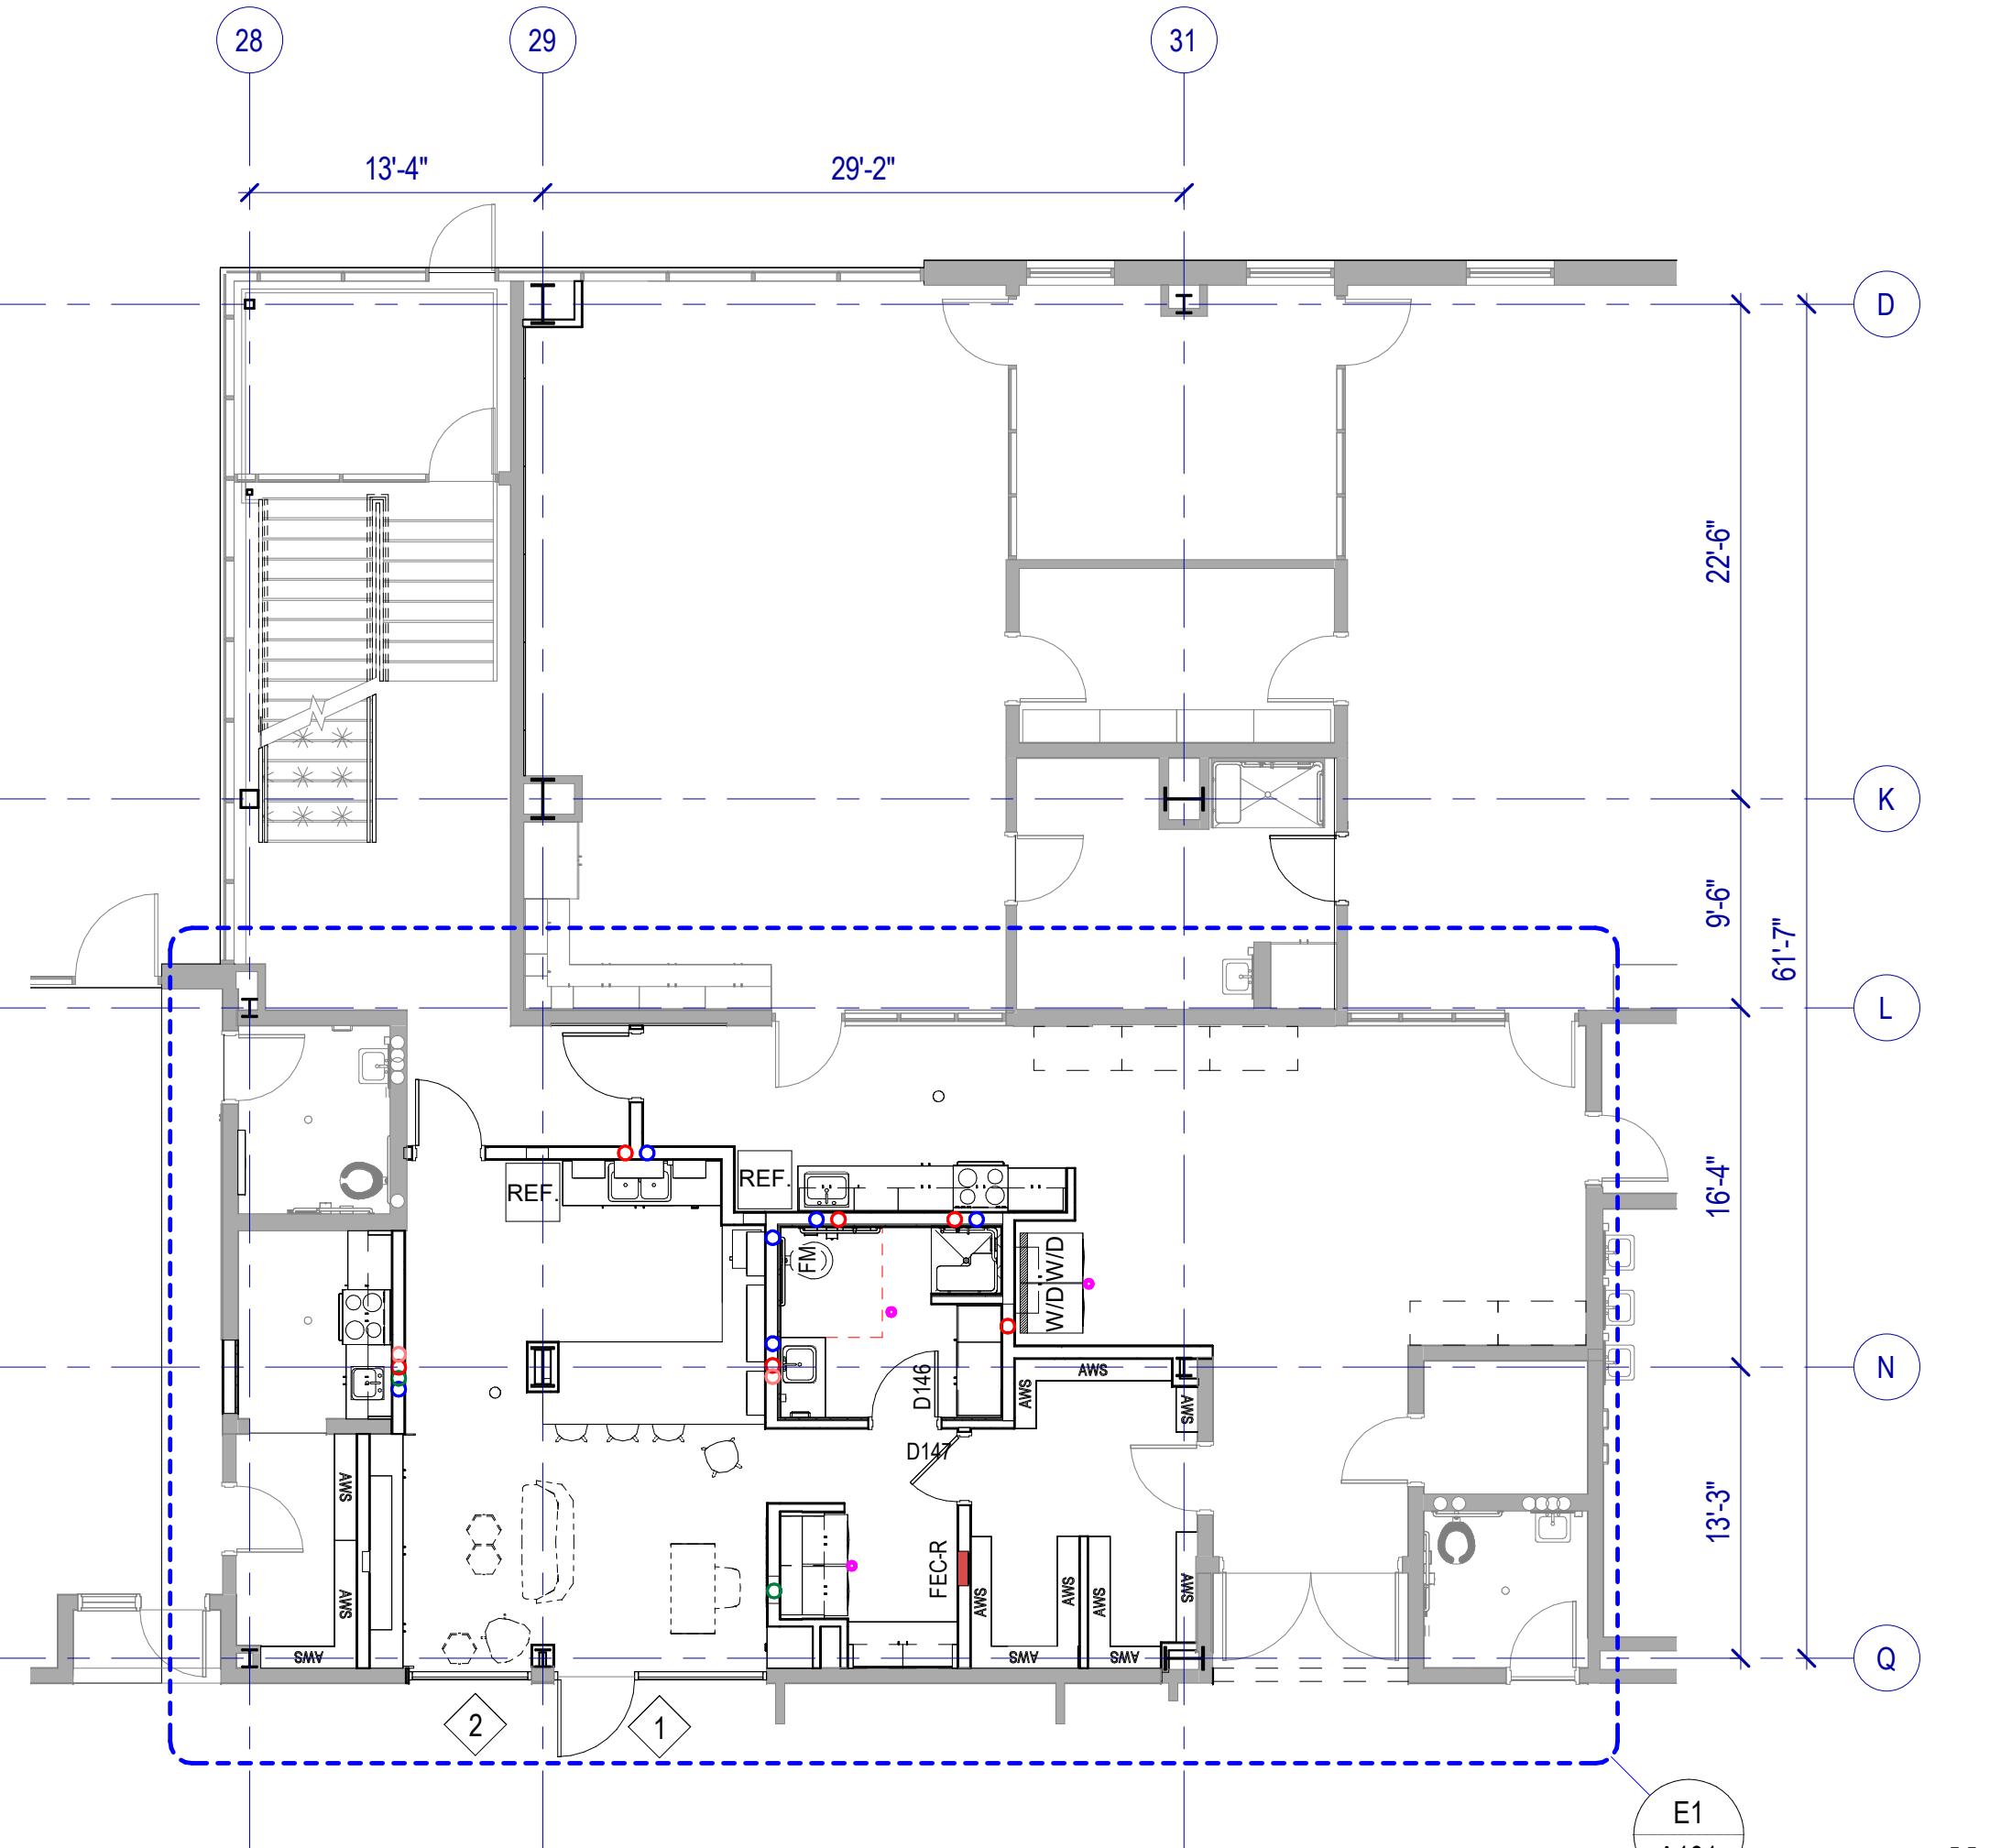


D1 FIRST FLOOR PLAN OVERALL

SCALE: 1/8" = 1'-0"

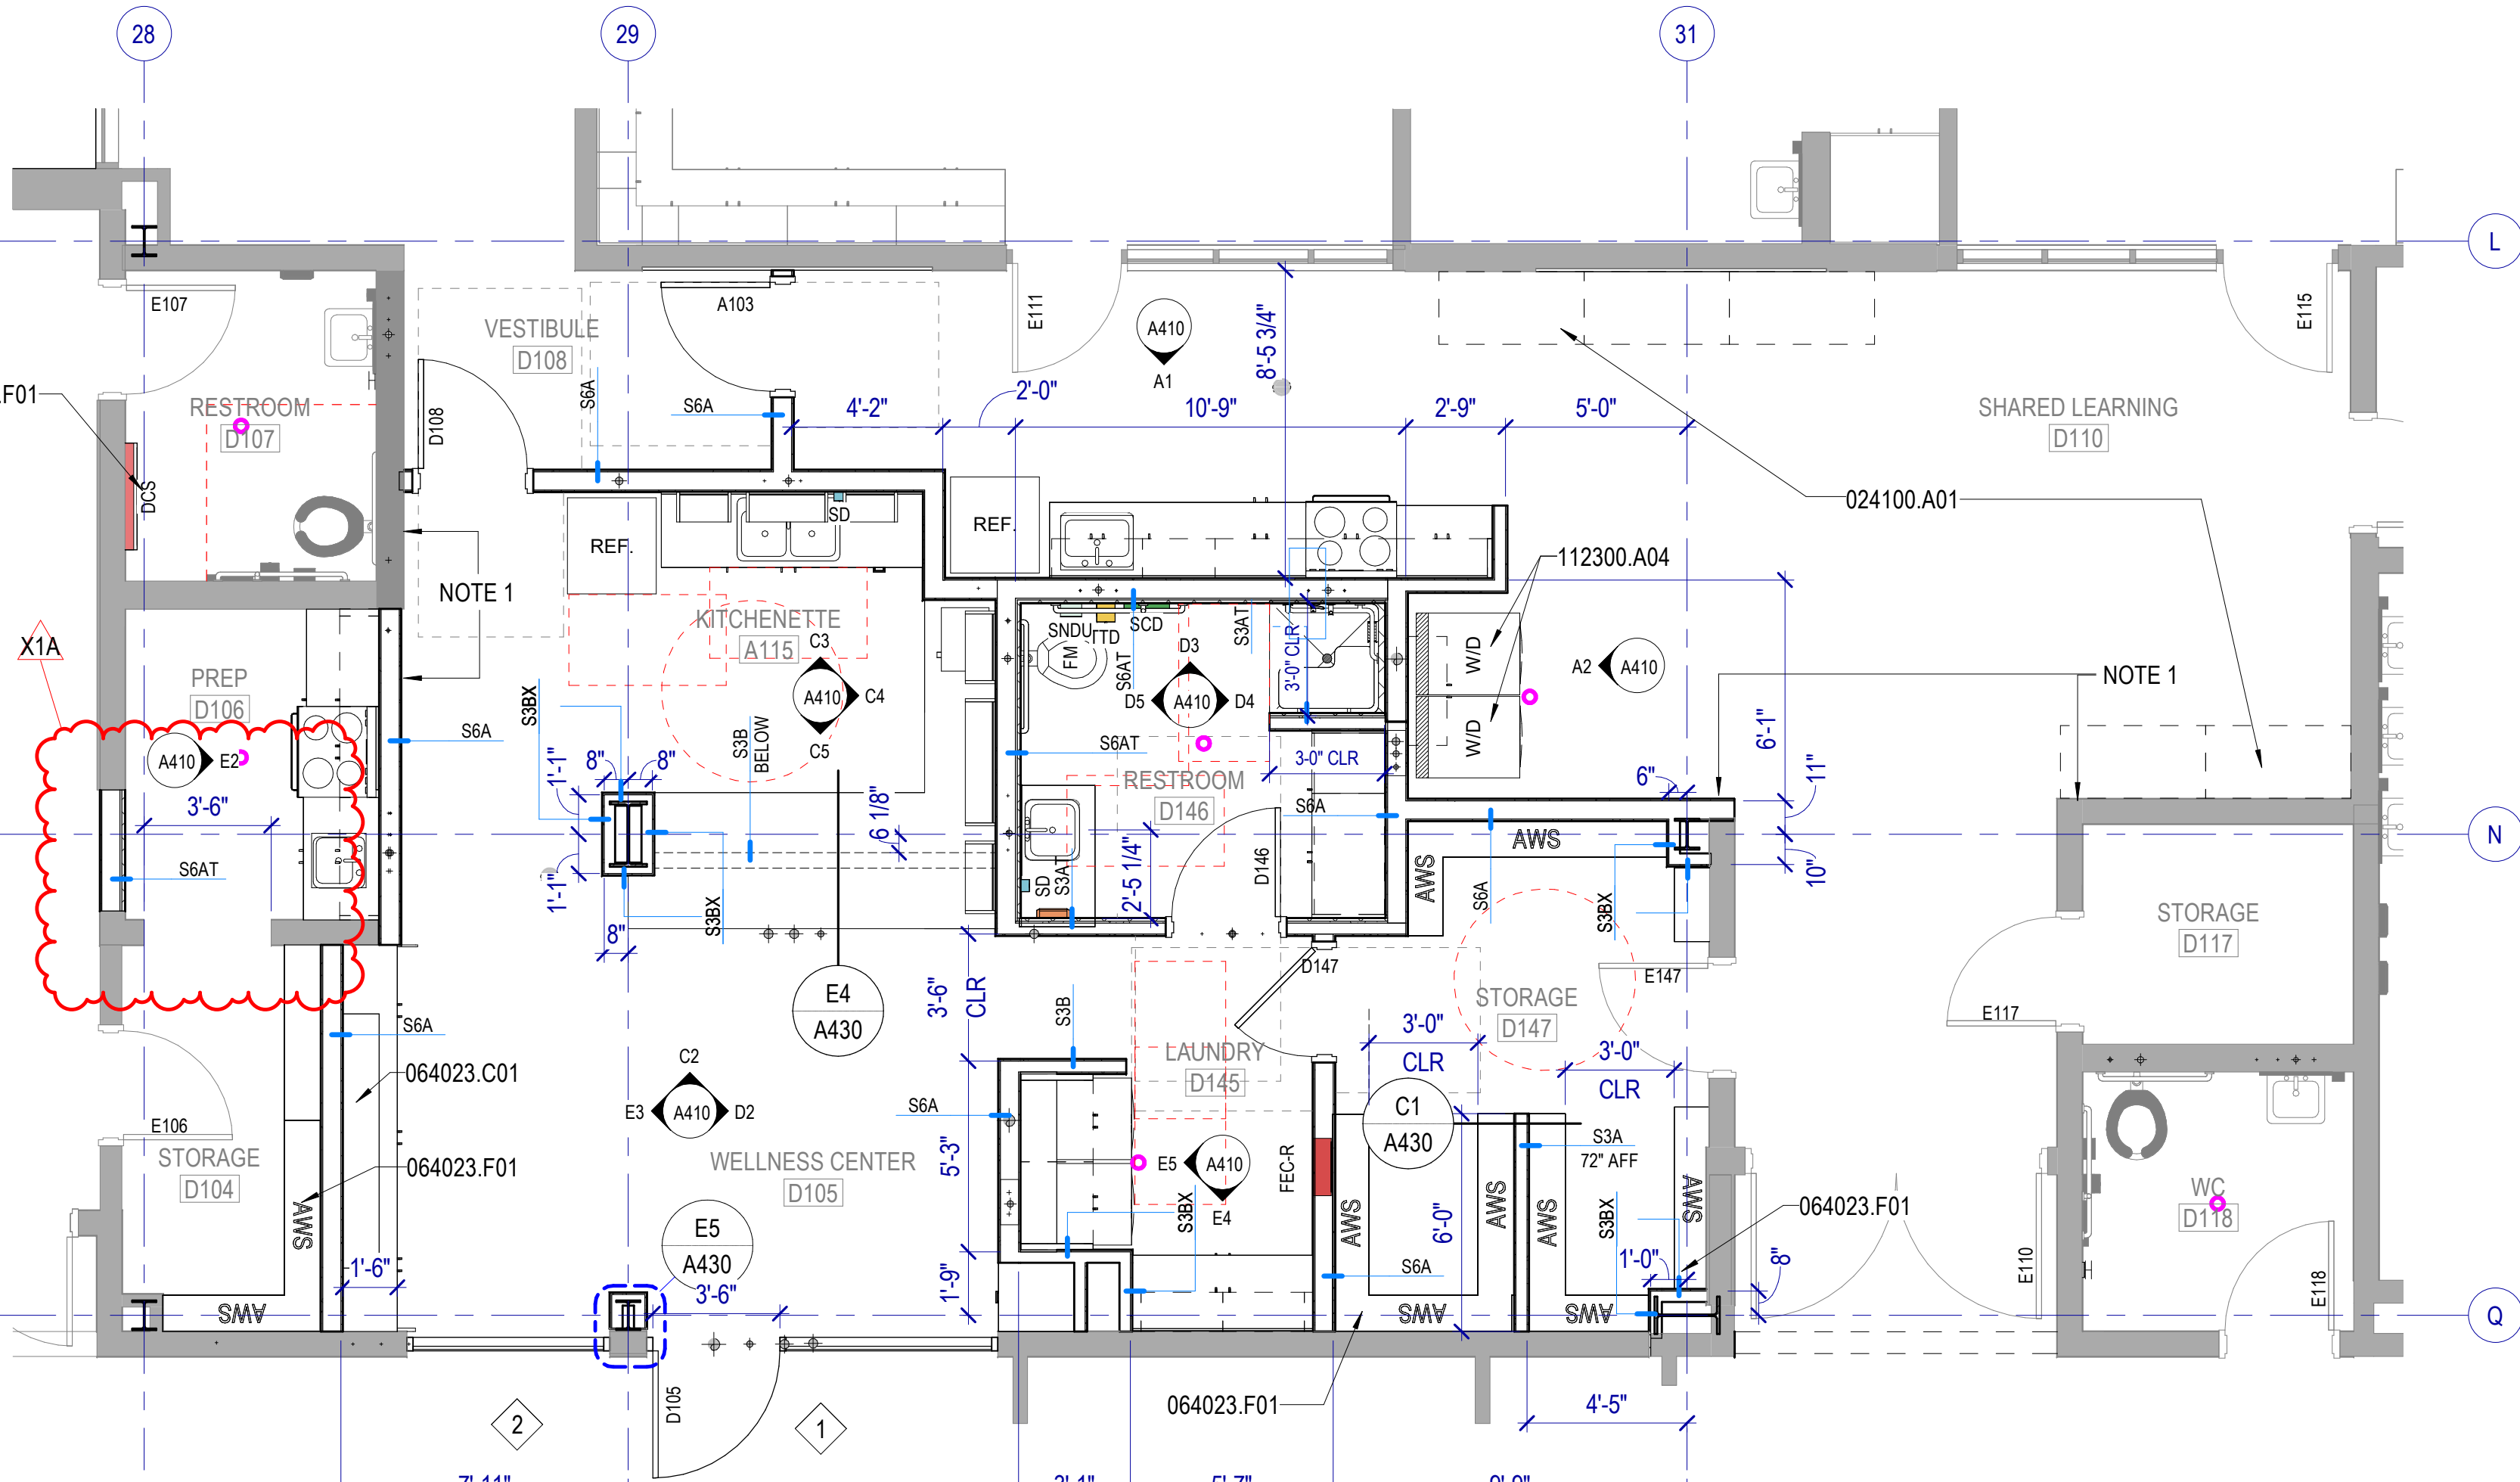

E1 FIRST FLOOR PLAN ENLARGED AREA


SCALE: 1/4" = 1'-0"

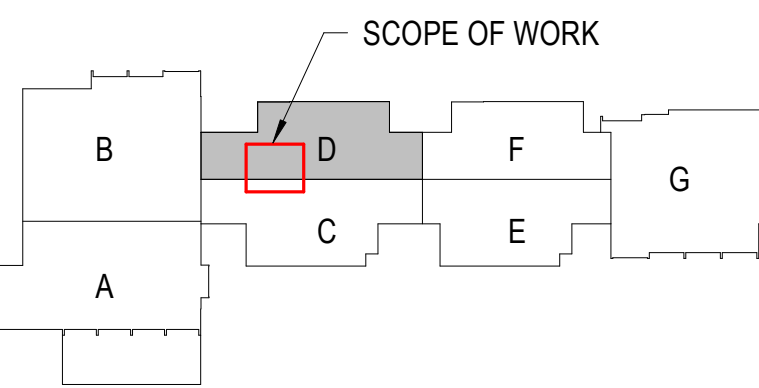

BUILDING KEYPLAN



MHTN Architects, Inc.
260 South 400 West
Suite 250
Salt Lake City, Utah 84101
Telephone (801) 595-6700
www.mhtn.com

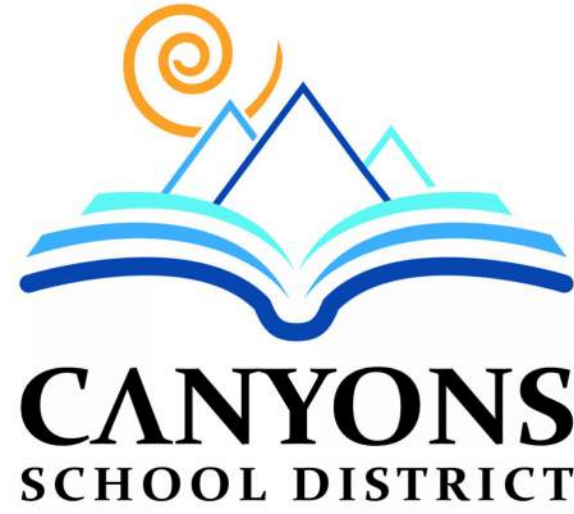

Canyons School District
Brighton High School Teen Center
2220 BENGAL BLVD
COTTONWOOD HEIGHTS, UT 84121

02023 MHTN ARCHITECTS, INC.
Confidentiality Notice
This document is intended for use on the Project identified herein by individuals and companies involved in the design, permitting, bidding and construction of the Project. MHTN Architects, Inc. and its affiliates do not warrant the accuracy or completeness of the information contained herein. This drawing is the property of MHTN Architects, Inc. and is not to be reproduced, distributed, or used for any other purpose without the written consent of MHTN Architects, Inc. If a digital copy of this document is received in error, please delete it.



MHTN PROJECT NO. 2024516

Original drawing is 30" x 42". Do not scale contents of this drawing.

REVISIONS:
CONTRACTOR TO VERIFY DRAWINGS IN FIELD USE REFLECT LAST REVISION DATE.

NO. DATE DESCRIPTION
X1A 03.14.25 BID ADD 9


ISSUE
BID DOCUMENTS
MARCH 1, 2025

SHEET NAME
FIRST FLOOR PLAN


SHEET NUMBER

A101


Autodesk Docs/2024516 CSD Brighton HS Teen Center/A24_2024516 BHS Teen Center.rvt 3/13/2025 2:14:30 PM

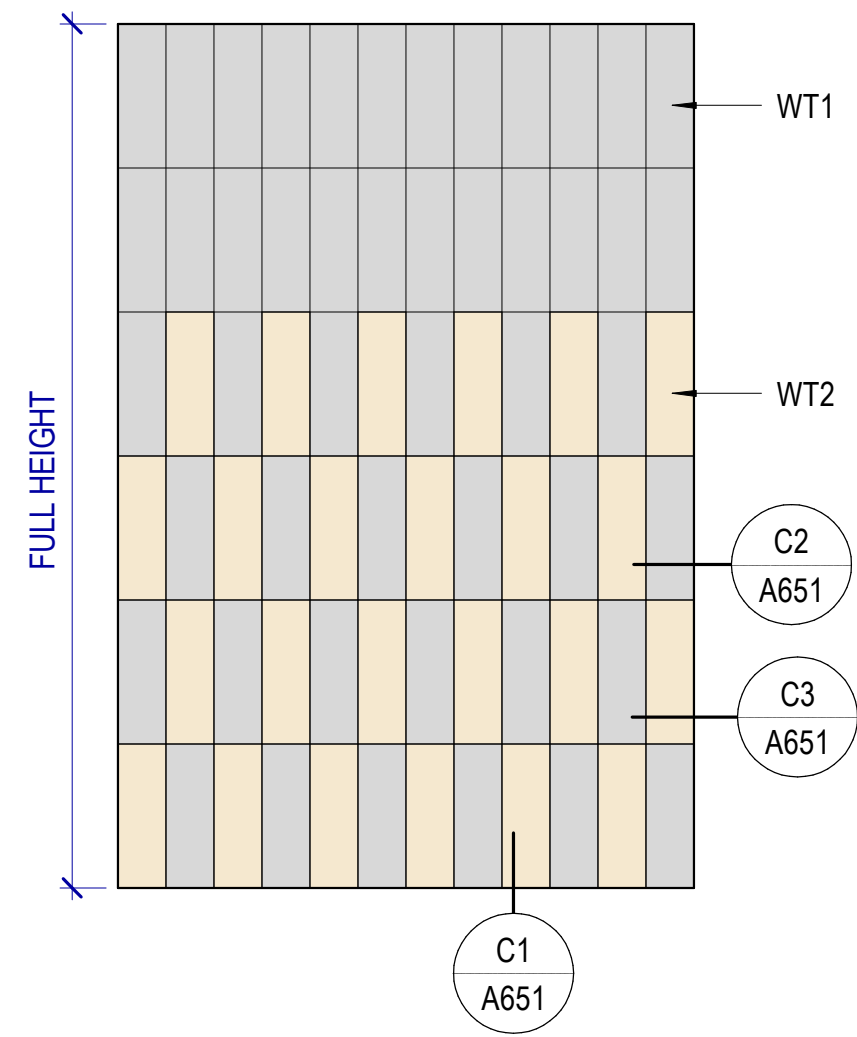


B1 WALL PATTERN TYPE 1
SCALE: 1/2" = 1'-0"

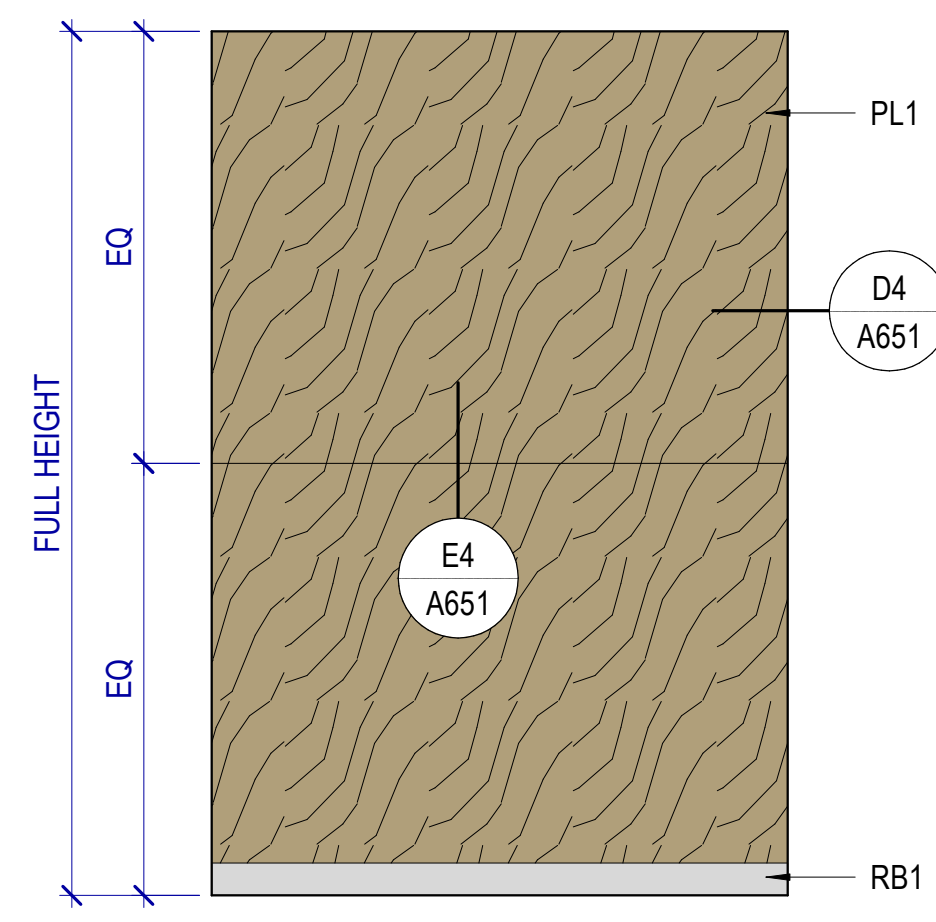


B2 WALL PATTERN TYPE 2
SCALE: 1/2" = 1'-0"

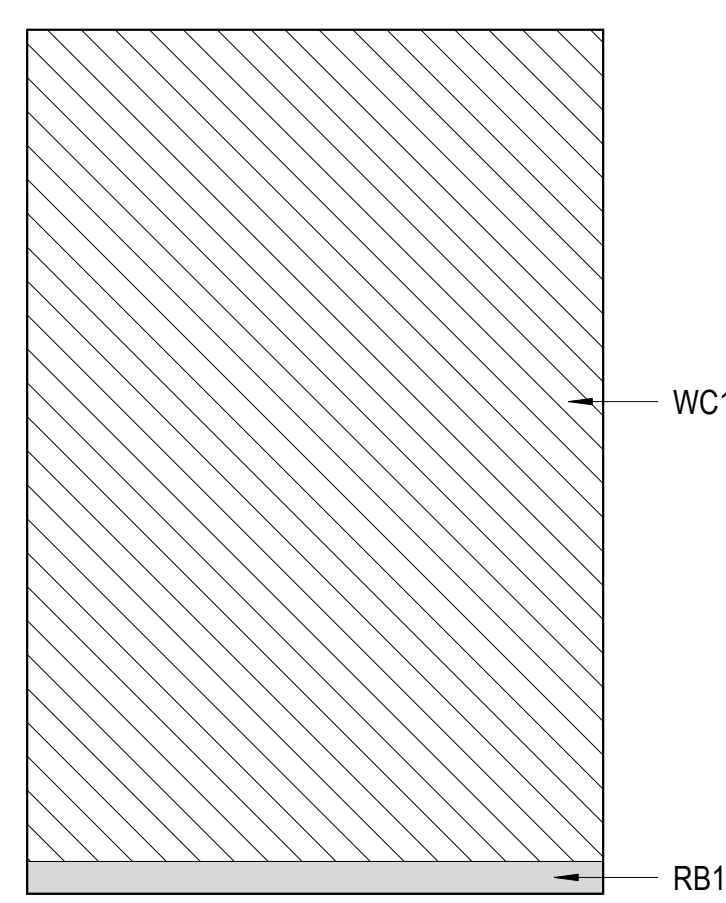


B3 WALL PATTERN TYPE 3
SCALE: 1/2" = 1'-0"

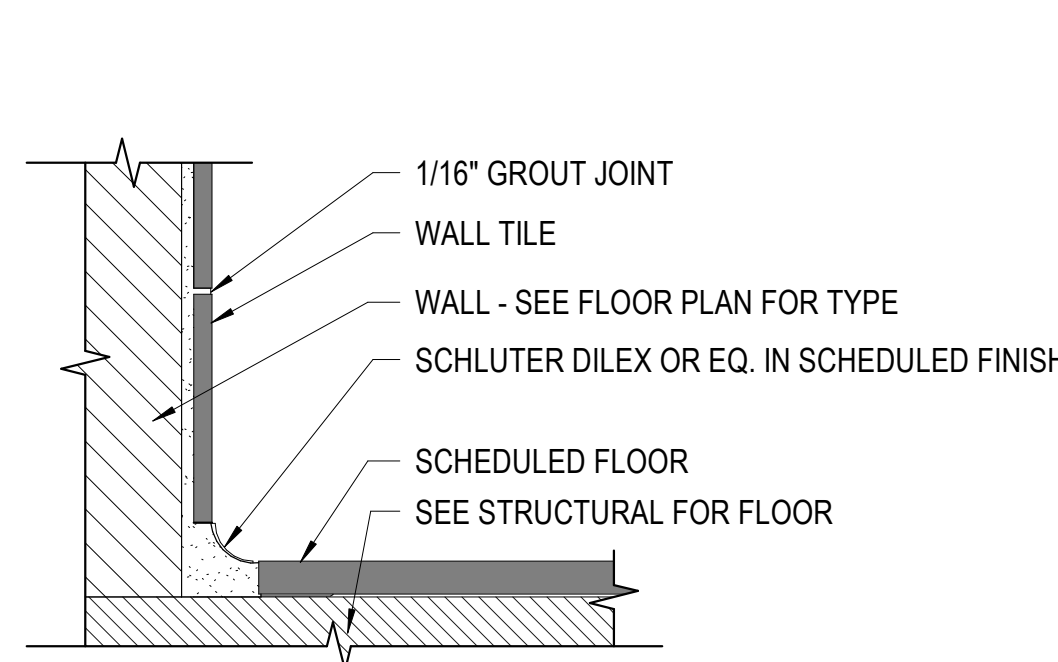


C1 TILE AT FLOOR
SCALE: 3" = 1'-0"

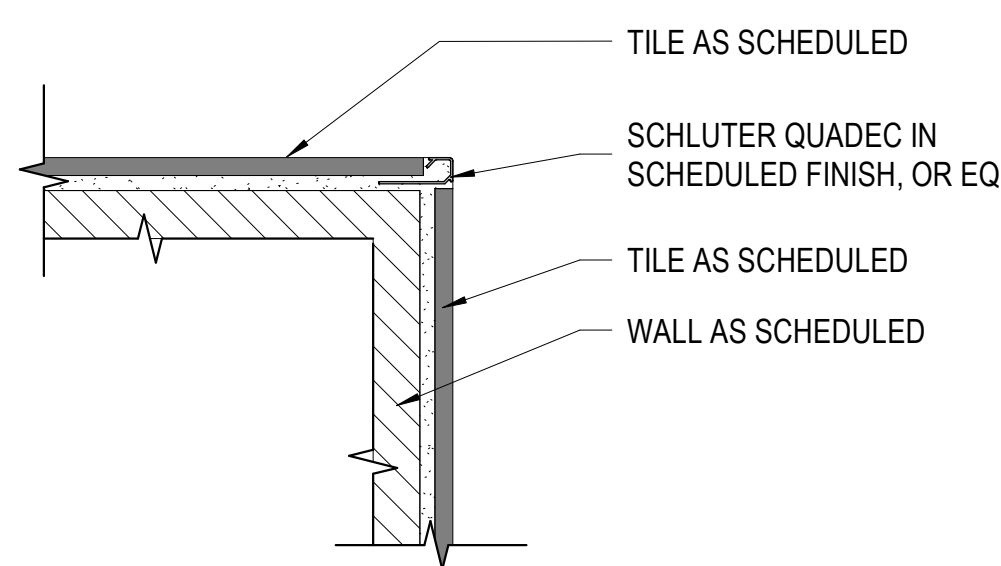


C2 TILE AT OUTSIDE CORNER
SCALE: 3" = 1'-0"

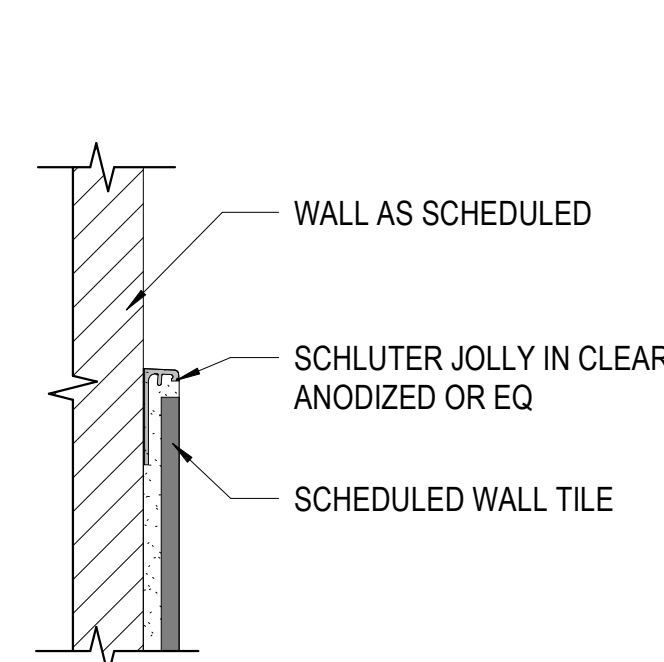


C3 TILE END CAP HOR & VERT
SCALE: 3" = 1'-0"

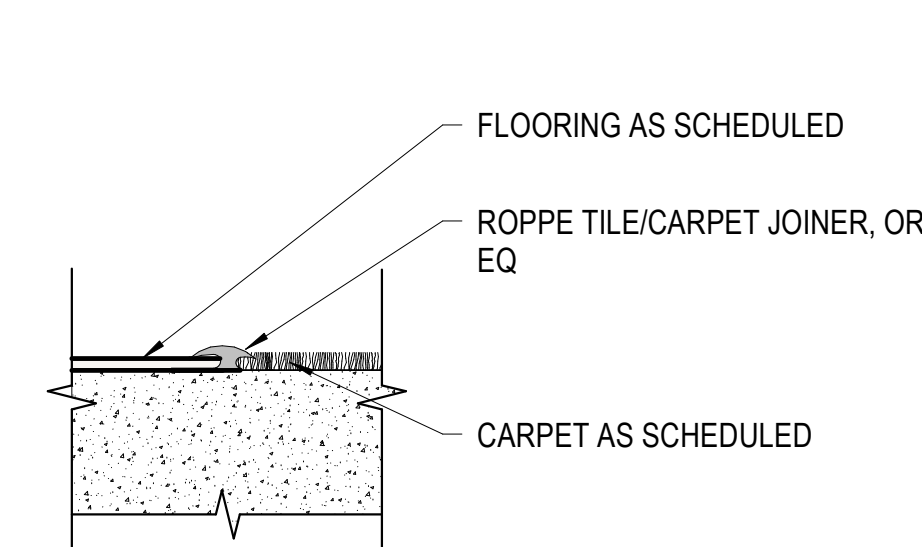


C4 CARPET TO RESILIENT
SCALE: 3" = 1'-0"

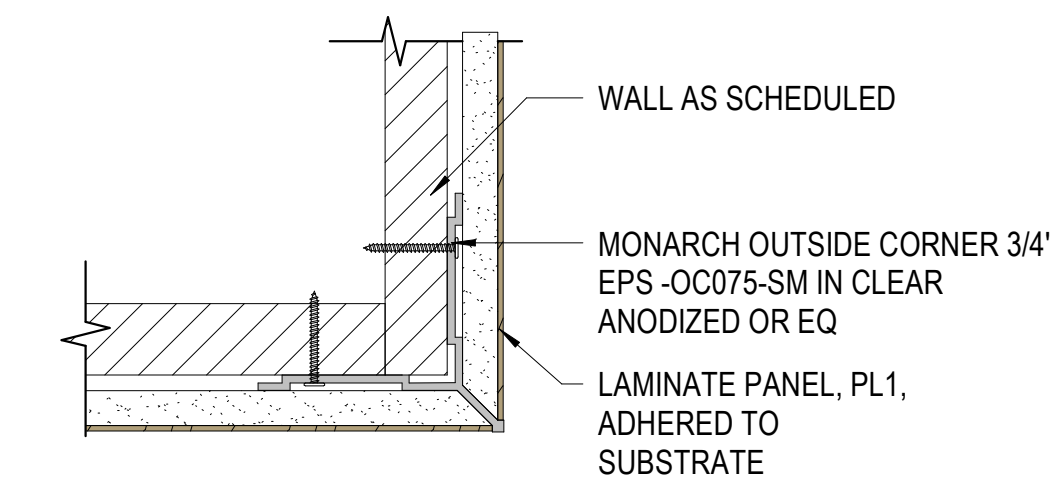

D4 LAMINATE OUTSIDE CORNER
SCALE: 3" = 1'-0"

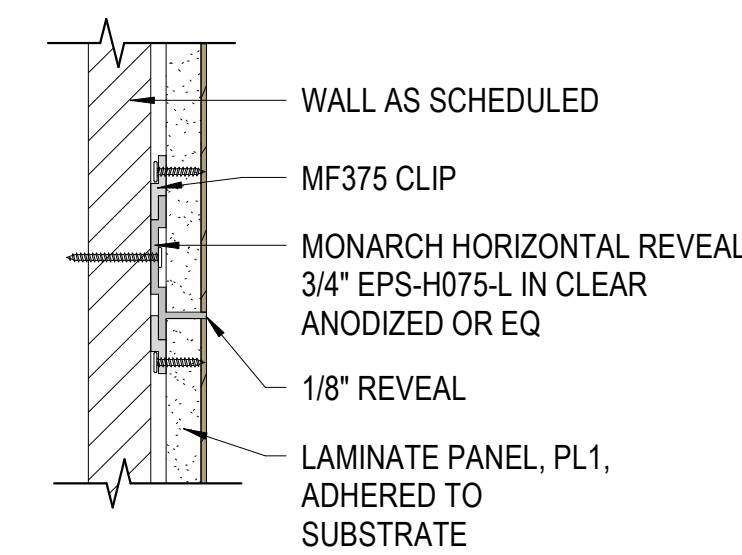

E4 LAMINATE REVEAL
SCALE: 3" = 1'-0"

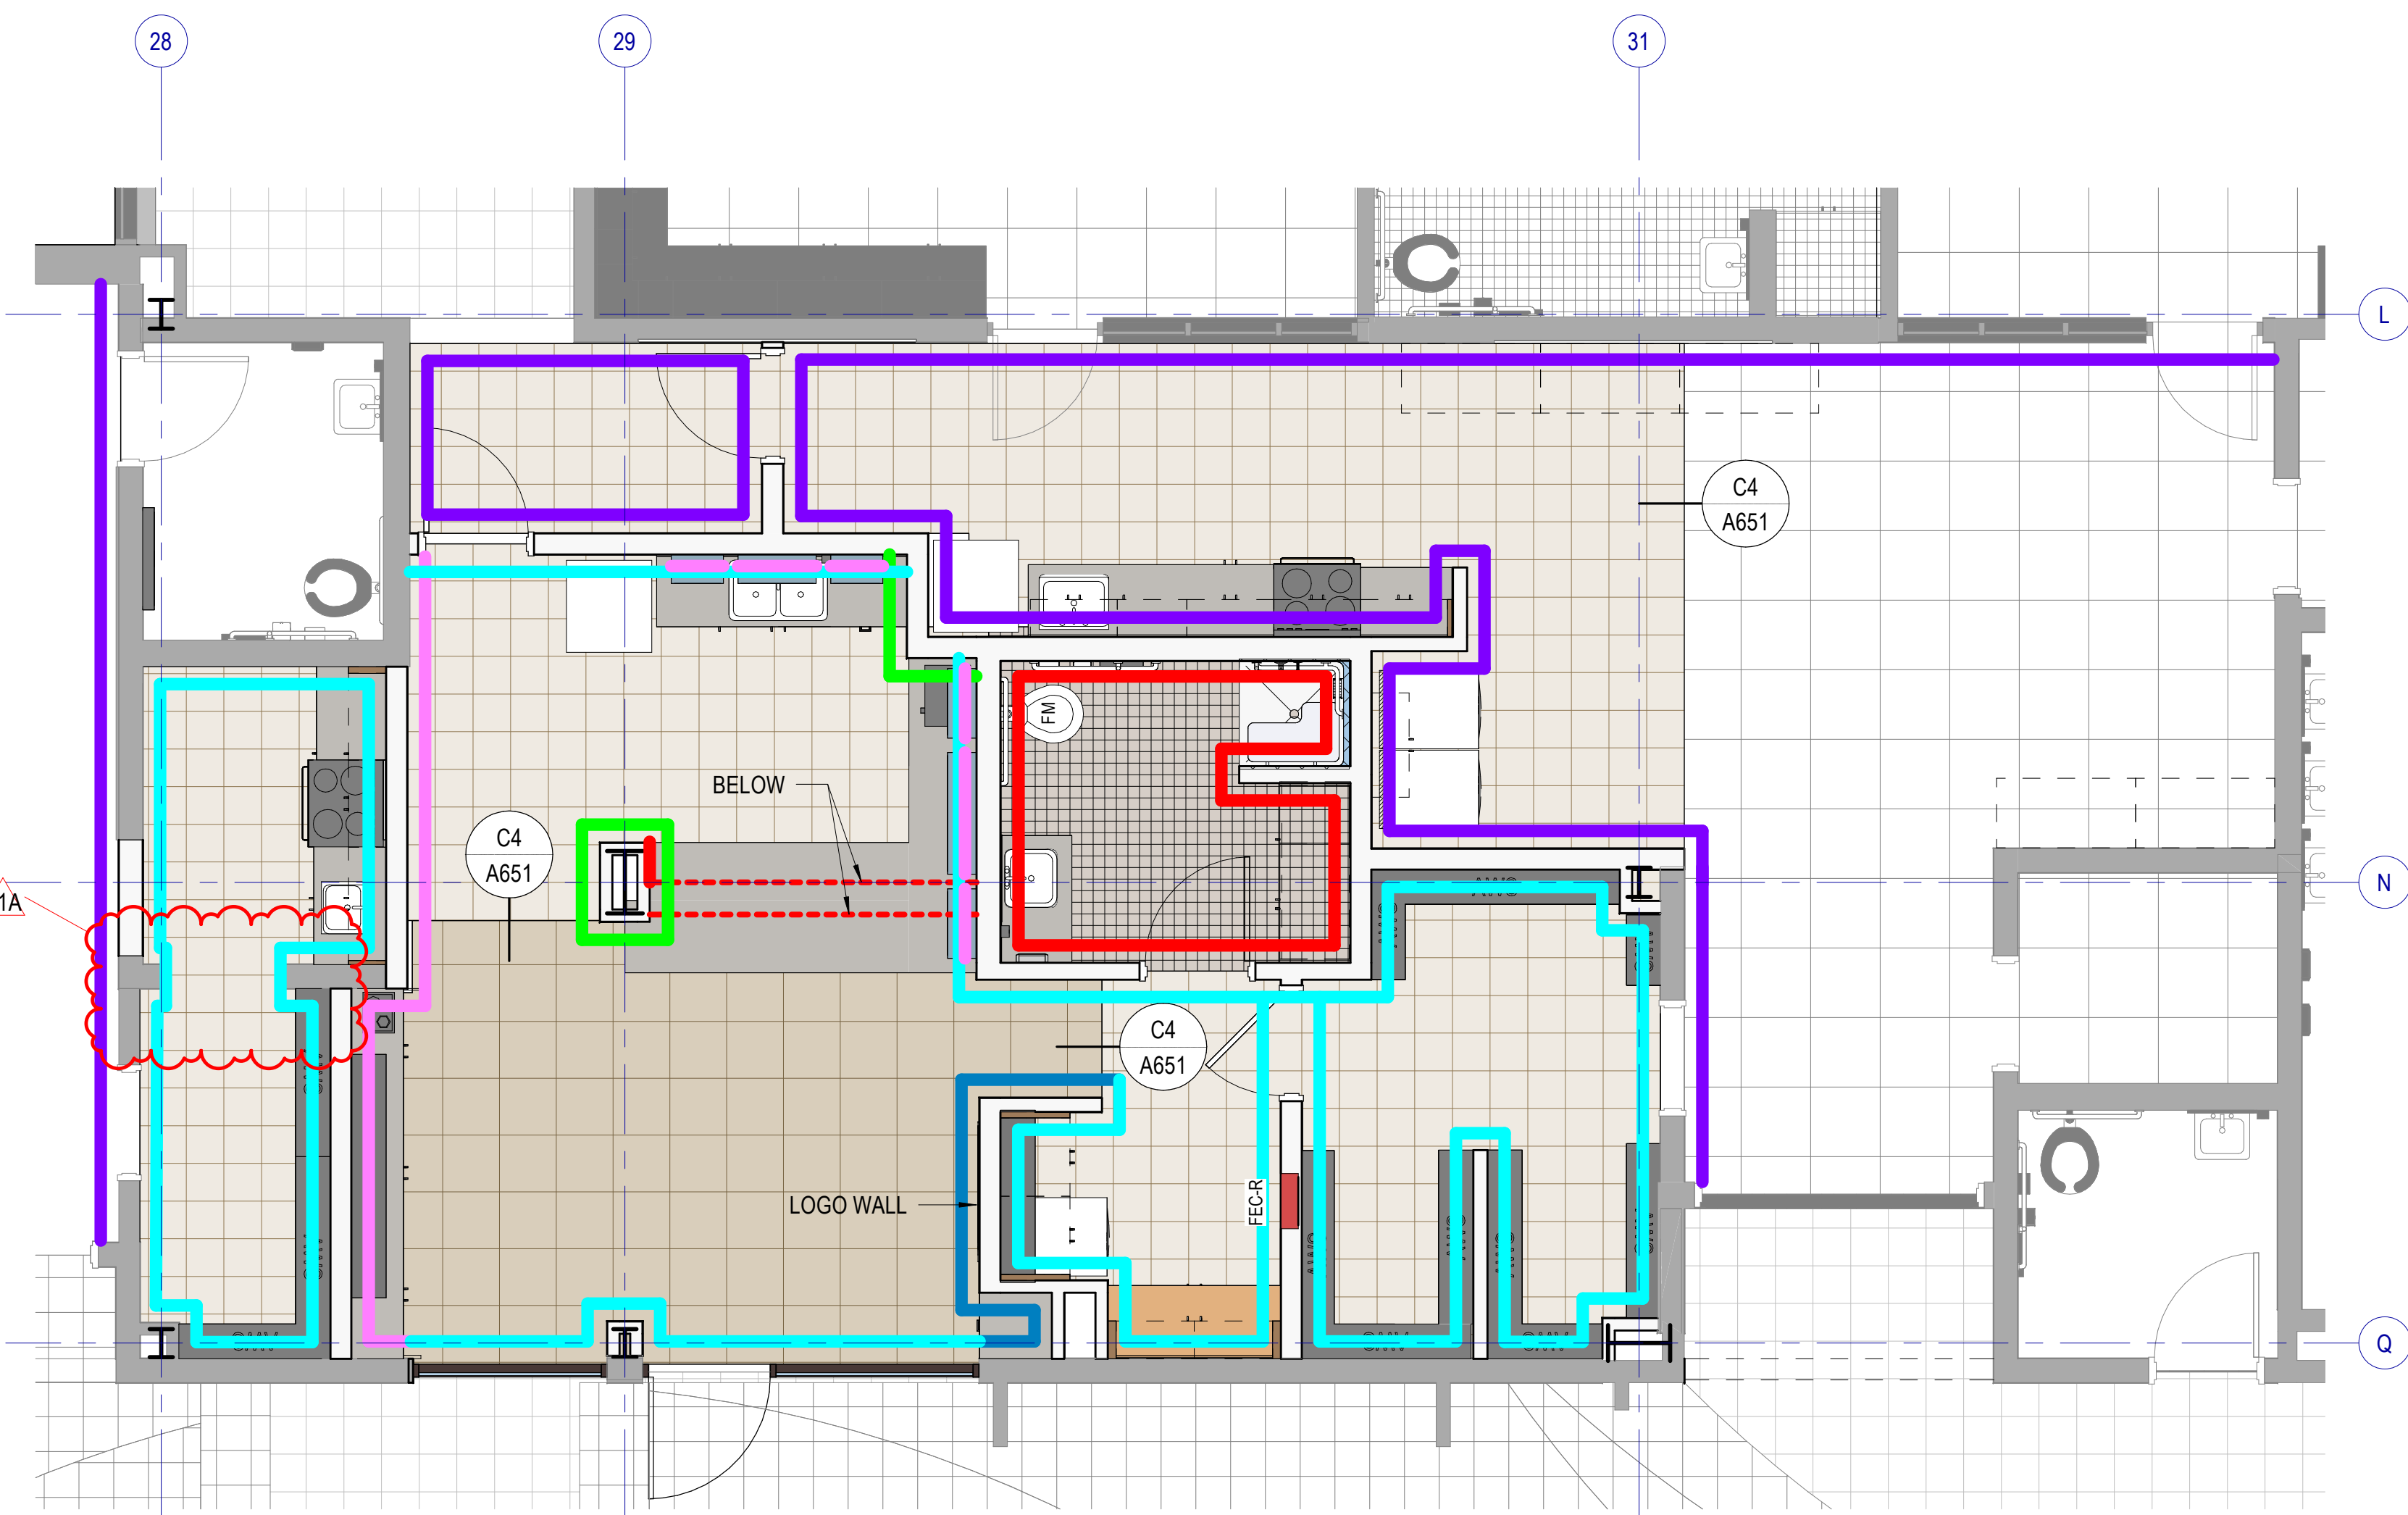

E1 FIRST FLOOR WALL PATTERN & FLOOR PATTERN PLAN
SCALE: 1/4" = 1'-0"

WALL FINISH LEGEND

WALL PATTERN TYPE 1	
WALL PATTERN TYPE 2	
WALL PATTERN TYPE 3	
PAIN, PT1 (WHITE)	
ACCENT PAIN, PT2 (BLUE)	
PAIN, (MATCH EXISTING)	


PATTERN PLAN GENERAL NOTES

RE: A640 for the Finish Schedule
RE: Axxx for typical floor finish transition details
RE: Structural drawings for recessed slabs.
Floor Finish Transitions at Doors: Locate floor finish material transitions that occur at doors under the center of the door, UNO.
Floor Drains: Coordinate location of floor drains with Plumbing drawings.

LEGEND - FLOOR PATTERN

	CARPET - CPT1
	EXISTING FLOORING
	RESILIENT FLOORING - RES1
	MOSAIC TILE - FT1

ISSUED BY MHTN ARCHITECTS, INC.
Confidentiality Notice
This document is intended for use on the Project identified herein by individuals and companies involved in the design, permitting, bidding and construction of the Project. MHTN Architects, Inc. grants no right to distribute and reproduction of this document for any purpose other than the Project is prohibited. If a digital copy of this document is received in error, please delete it.

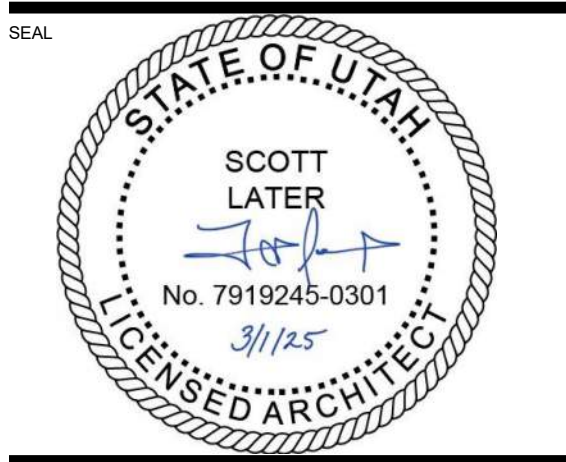

MHTN PROJECT NO. 2024516
VIEW AND PRINT THIS DRAWING IN COLOR

Original drawing is 36" x 42". Do not scale contents of this drawing.

REVISIONS:
CONTRACTOR TO VERIFY DRAWINGS IN FIELD USE REFLECT LAST REVISION DATE.


NO.	DATE	DESCRIPTION
X1A	03.14.25	BID ADD 3

ISSUE
BID DOCUMENTS
MARCH 1, 2025


SHEET NAME
FIRST FLOOR WALL PATTERN & FLOOR PATTERN PLAN

SHEET NUMBER

A651

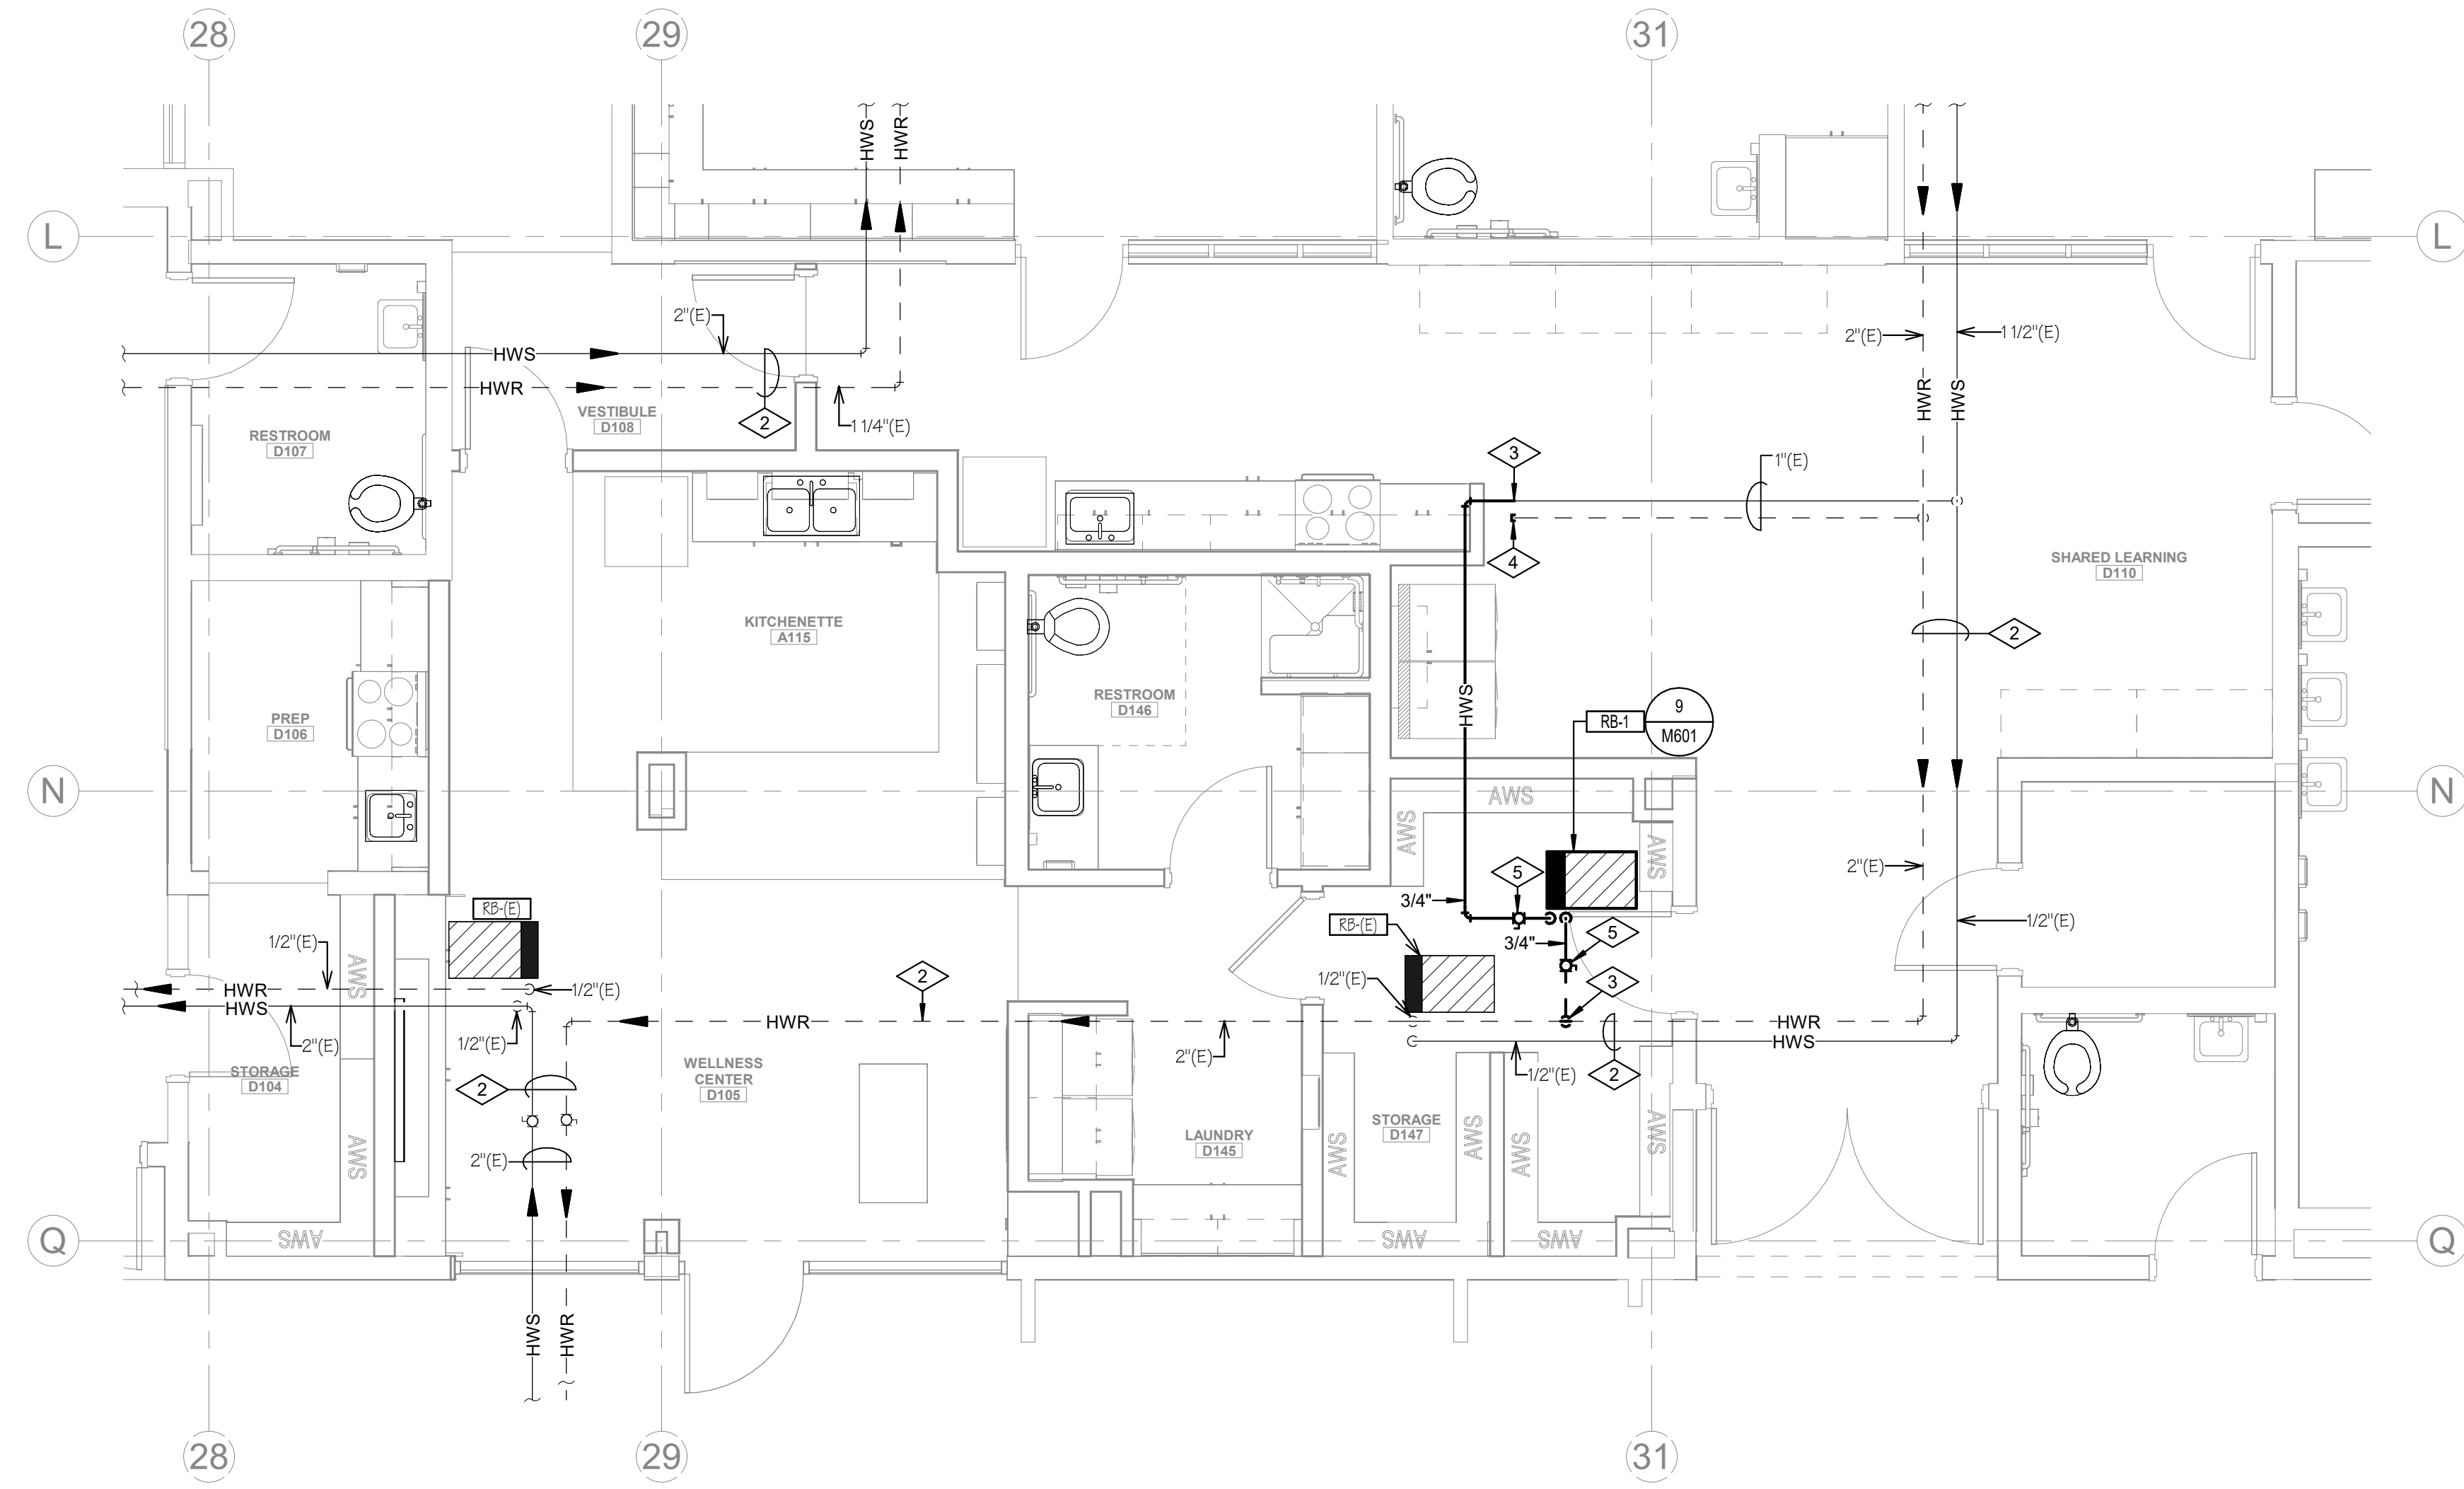


FIRST FLOOR MECHANICAL PIPING PLAN

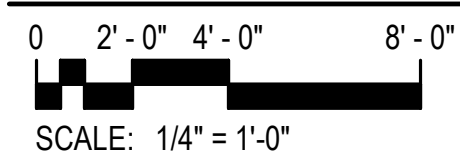

- 1 REMOVE EXISTING HWS & HWR PIPING BACK TO THIS APPROXIMATE LOCATION.
- 2 EXISTING PIPING TO REMAIN.
- 3 TIE INTO EXISTING PIPING ABOVE CEILING AT THIS APPROXIMATE LOCATION.
- 4 CAP PIPING ABOVE CEILING IN THIS APPROXIMATE LOCATION.
- 5 LINE SIZE BALL VALVE. VALVE MUST BE IN AN ACCESSIBLE LOCATION.

Autodesk Docs 2024516 CSD Brighton HS Teen Center/CSD Brighton HS - Teen Center ELEC V24-14
3/14/2025 4:09:44 PM

LIGHT FIXTURE SCHEDULE									
LIGHT FIXTURE ABBREVIATION SCHEDULE						PROJECT MANAGER: DRAYTONMICAH			
A.F.F.	ABOVE FINISH FLOOR	SCBA	STANDARD PAINTED COLOR AS SELECTED BY THE ARCHITECT						
WALL/CLG	WALL MOUNT AT CORNER OF WALL AND CEILING	CFBA	CUSTOM FINISH AS SELECTED BY THE ARCHITECT						
CCBA	CUSTOM PAINTED COLOR AS SELECTED BY THE ARCHITECT	SFBA	STANDARD FINISH AS SELECTED BY THE ARCHITECT						
LIGHT FIXTURE GENERAL NOTES									
1. REFER TO ARCHITECTURAL REFLECTED CEILING PLANS FOR LOCATIONS OF LIGHT FIXTURES AND, CONFIRM CEILING TYPES WITH LIGHT FIXTURE TRIMS. BRING ALL DISCREPANCIES OF LOCATIONS AND QUANTITIES TO THE ATTENTION OF THE ARCHITECT AND ELECTRICAL ENGINEER PRIOR TO BIDDING.									
2. REFER TO ARCHITECTURAL ELEVATIONS FOR MOUNTING HEIGHTS AND LOCATIONS OF LIGHT FIXTURES. BRING ALL DISCREPANCIES TO THE ATTENTION OF THE ARCHITECT PRIOR TO BIDDING.									
3. REFER TO THE SPECIFICATIONS FOR OTHER LIGHT FIXTURE, FUSING, LED DRIVERS, AND LAMP REQUIREMENTS AND ACCEPTABLE MANUFACTURERS.									
4. CONFIRM AVAILABLE MOUNTING DEPTHS OF ALL LIGHT FIXTURES AND COMPARE WITH DEPTHS SHOWN ON SHOP DRAWINGS. BRING ALL POTENTIAL CONFLICT AREAS TO THE ATTENTION OF THE ARCHITECT AND ELECTRICAL ENGINEER PRIOR TO...									
5. REFER TO LIGHTING PLANS FOR ALL LINEAR FIXTURE LENGTHS. THE CATALOG NUMBER IS BASED ON THE FIXTURE SPECIFIED AND MAY NOT REFLECT THE QUANTITY OR OVERALL LENGTH OF LINEAR FIXTURES REQUIRED. CONTRACTOR TO NOTE THAT VARIOUS FIXTURE LENGTHS MAY BE REQUIRED TO ACHIEVE THE OVERALL RUN LENGTH.									
6. REFER TO LIGHTING PLANS FOR ALL UNDERCABINET FIXTURE LENGTHS. THE CATALOG NUMBER IS BASED ON THE FIXTURE SPECIFIED AND MAY NOT REFLECT THE QUANTITY OR OVERALL LENGTH OF THE UNDERCABINET FIXTURES REQUIRED. CONTRACTOR TO NOTE THAT VARIOUS FIXTURE LENGTHS MAY BE REQUIRED TO ACHIEVE THE OVERALL RUN LENGTH OR TO FIT WITHIN THE MILLWORK. COORDINATE FIXTURE LAYOUT WITH MILLWORK SHOP DRAWINGS PRIOR TO LIGHTING SUBMITTALS.									
7. WHEN A CONTRADICTION EXISTS BETWEEN A SPECIFIC MODEL NUMBER AND THE DESCRIPTION, NOTIFY THE ELECTRICAL ENGINEER AND/OR LIGHTING DESIGNER.									
8. PRIOR APPROVALS ARE REQUIRED BEFORE BIDDING THE PROJECT AND SHALL BE SUBMITTED TO THE ELECTRICAL ENGINEER'S OFFICE AT LEAST (8) EIGHT WORKING DAYS BEFORE THE BID. PRIOR APPROVALS RECEIVED AFTER THIS TIME PERIOD SHALL...									
9. REFER TO SPECIFICATIONS 20 0500, 26 5100 & 26 5600 (16001, 16510 & 16551).									
10. VALUE ENGINEERING CONDUCTED WITHOUT THE DESIGN TEAM (E, ARCHITECT, ENGINEER & LIGHTING CONSULTANT/DESIGNER WILL NOT BE ALLOWED, REVIEWED OR APPROVED.									
TYPE	DESCRIPTION	MFR.	CATALOG #	TOTAL WATTS	LAMP TYPE	DELIVERED LUMENS	COLOR TEMP.	CRI	
B26	2X2' HIGH EFFICIENT LED ARCHITECTURALLY STYLED RECESSED LUMINAIRE, RIBBED FROSTED CENTER LENS, LOW PROFILE BODY, EASY ACCESS TO COMPONENTS, 66,000 HOUR (L80), 0-10 DIMMING, 5 YR. WARRANTY	COLUMBIA	LCA722-S-30L029G-EDU	19	LED	2,610	4000 K	80+	
B260	2X2' HIGH EFFICIENT LED ARCHITECTURALLY STYLED RECESSED LUMINAIRE, RIBBED FROSTED CENTER LENS, INTEGRAL OCCUPANCY/PHOTOCELL PROGRAM FOR A 15-20 MINUTE DELAY, LOW PROFILE BODY, EASY ACCESS TO COMPONENTS, 66,000 HOUR (L80), 0-10 DIMMING, 5 YR. WARRANTY	COLUMBIA	LCA722-S-30L029G-EDU-OPDG	19	LED	2,610	4000 K	80+	
EXF	EXISTING FIXTURE REINSTALL			4watt		1,380	4000 K	85+	
PL35	PENDANT MOUNTED 2" WIDE LED LINEAR SLOT LED LUMINAIRE, EXTRUDED ALUMINUM, SATINE ICE DIFFUSE OPTIC LENS, BUILT TO LENGTH, VERIFY LENGTHS WITH ARCHITECTURAL PLANS (1" INCREMENTS REQUIRED), STANDARD COLOR BY ARCHITECT (BL, AL, WH, ETC), FIXTURE HUNG BETWEEN ARCHITECTURAL WOOD BAFFLES/PLANK CEILING, 5 YR. WARRANTY, 0-10V DIMMING	STARTEK	SLIMD-XX(SEE PLANS-350-SD-30K-80-SCBA-ACBS-U-1C)		LED	2,275	4000 K	80+	
PL50	PENDANT MOUNTED 2" WIDE LED LINEAR SLOT LED LUMINAIRE, EXTRUDED ALUMINUM, WIDE DIFFUSE LAMBERTIAN OPTIC LENS, VERIFY LENGTHS WITH ARCHITECTURAL PLANS (1" INCREMENTS REQUIRED), STANDARD COLOR BY ARCHITECT (BL, AL, WH, ETC), FIXTURE HUNG BETWEEN ARCHITECTURAL WOOD BAFFLES/PLANK CEILING, 5 YR. WARRANTY, 0-10V DIMMING	STARTEK	SLIMD-S-625-VD-30K-80-SCBA-ACBS-U-1C	45	LED	5,000	4000 K	80+	
SD6	6" ROUND SURFACE MOUNTED LED LUMINAIRE, LOW PROFILE, MOUNTS IN STANDARD 4" DEEP OCTAGONAL JUNCTION BOX, PROVIDE JUNCTION BOX/HOUSING AS REQUIRED, 50,000 HOUR (L70), 5 YR. WARRANTY, 0-10 DIMMING, FIELD-SELECTABLE LUMEN OUTPUT (HIGH, 3000K)	PRESCOLITE	LBES-6RD-CS9-WH	13	LED	1,100	4000 K	80+	
VL	WALL MOUNTED LINEAR RECTANGULAR LED VANITY, WHITE ACRYLIC DIFFUSER, STANDARD COLOR BY ARCHITECT (BL, AL, WH, ETC), 60,000 HOUR (L70), 0-10 DIMMING	WAC LIGHTING	WS-77624-3000K-SCBA-11	21	LED	1,440	4000 K	80+	
X1	UNIVERSAL EDGE-LIT EXIT SIGN, BRUSHED ALUMINUM HOUSING AND BLACK PLASTIC END-CAPS, WITH HIGH GRADE ACRYLIC PANEL, UNIVERSAL MOUNT SURFACE, RECESSED OR END-MOUNT, AC ONLY	EMERGH-LITE OR BEGHELLI	PAG6	3.3	LED	100	4000 K	80+	

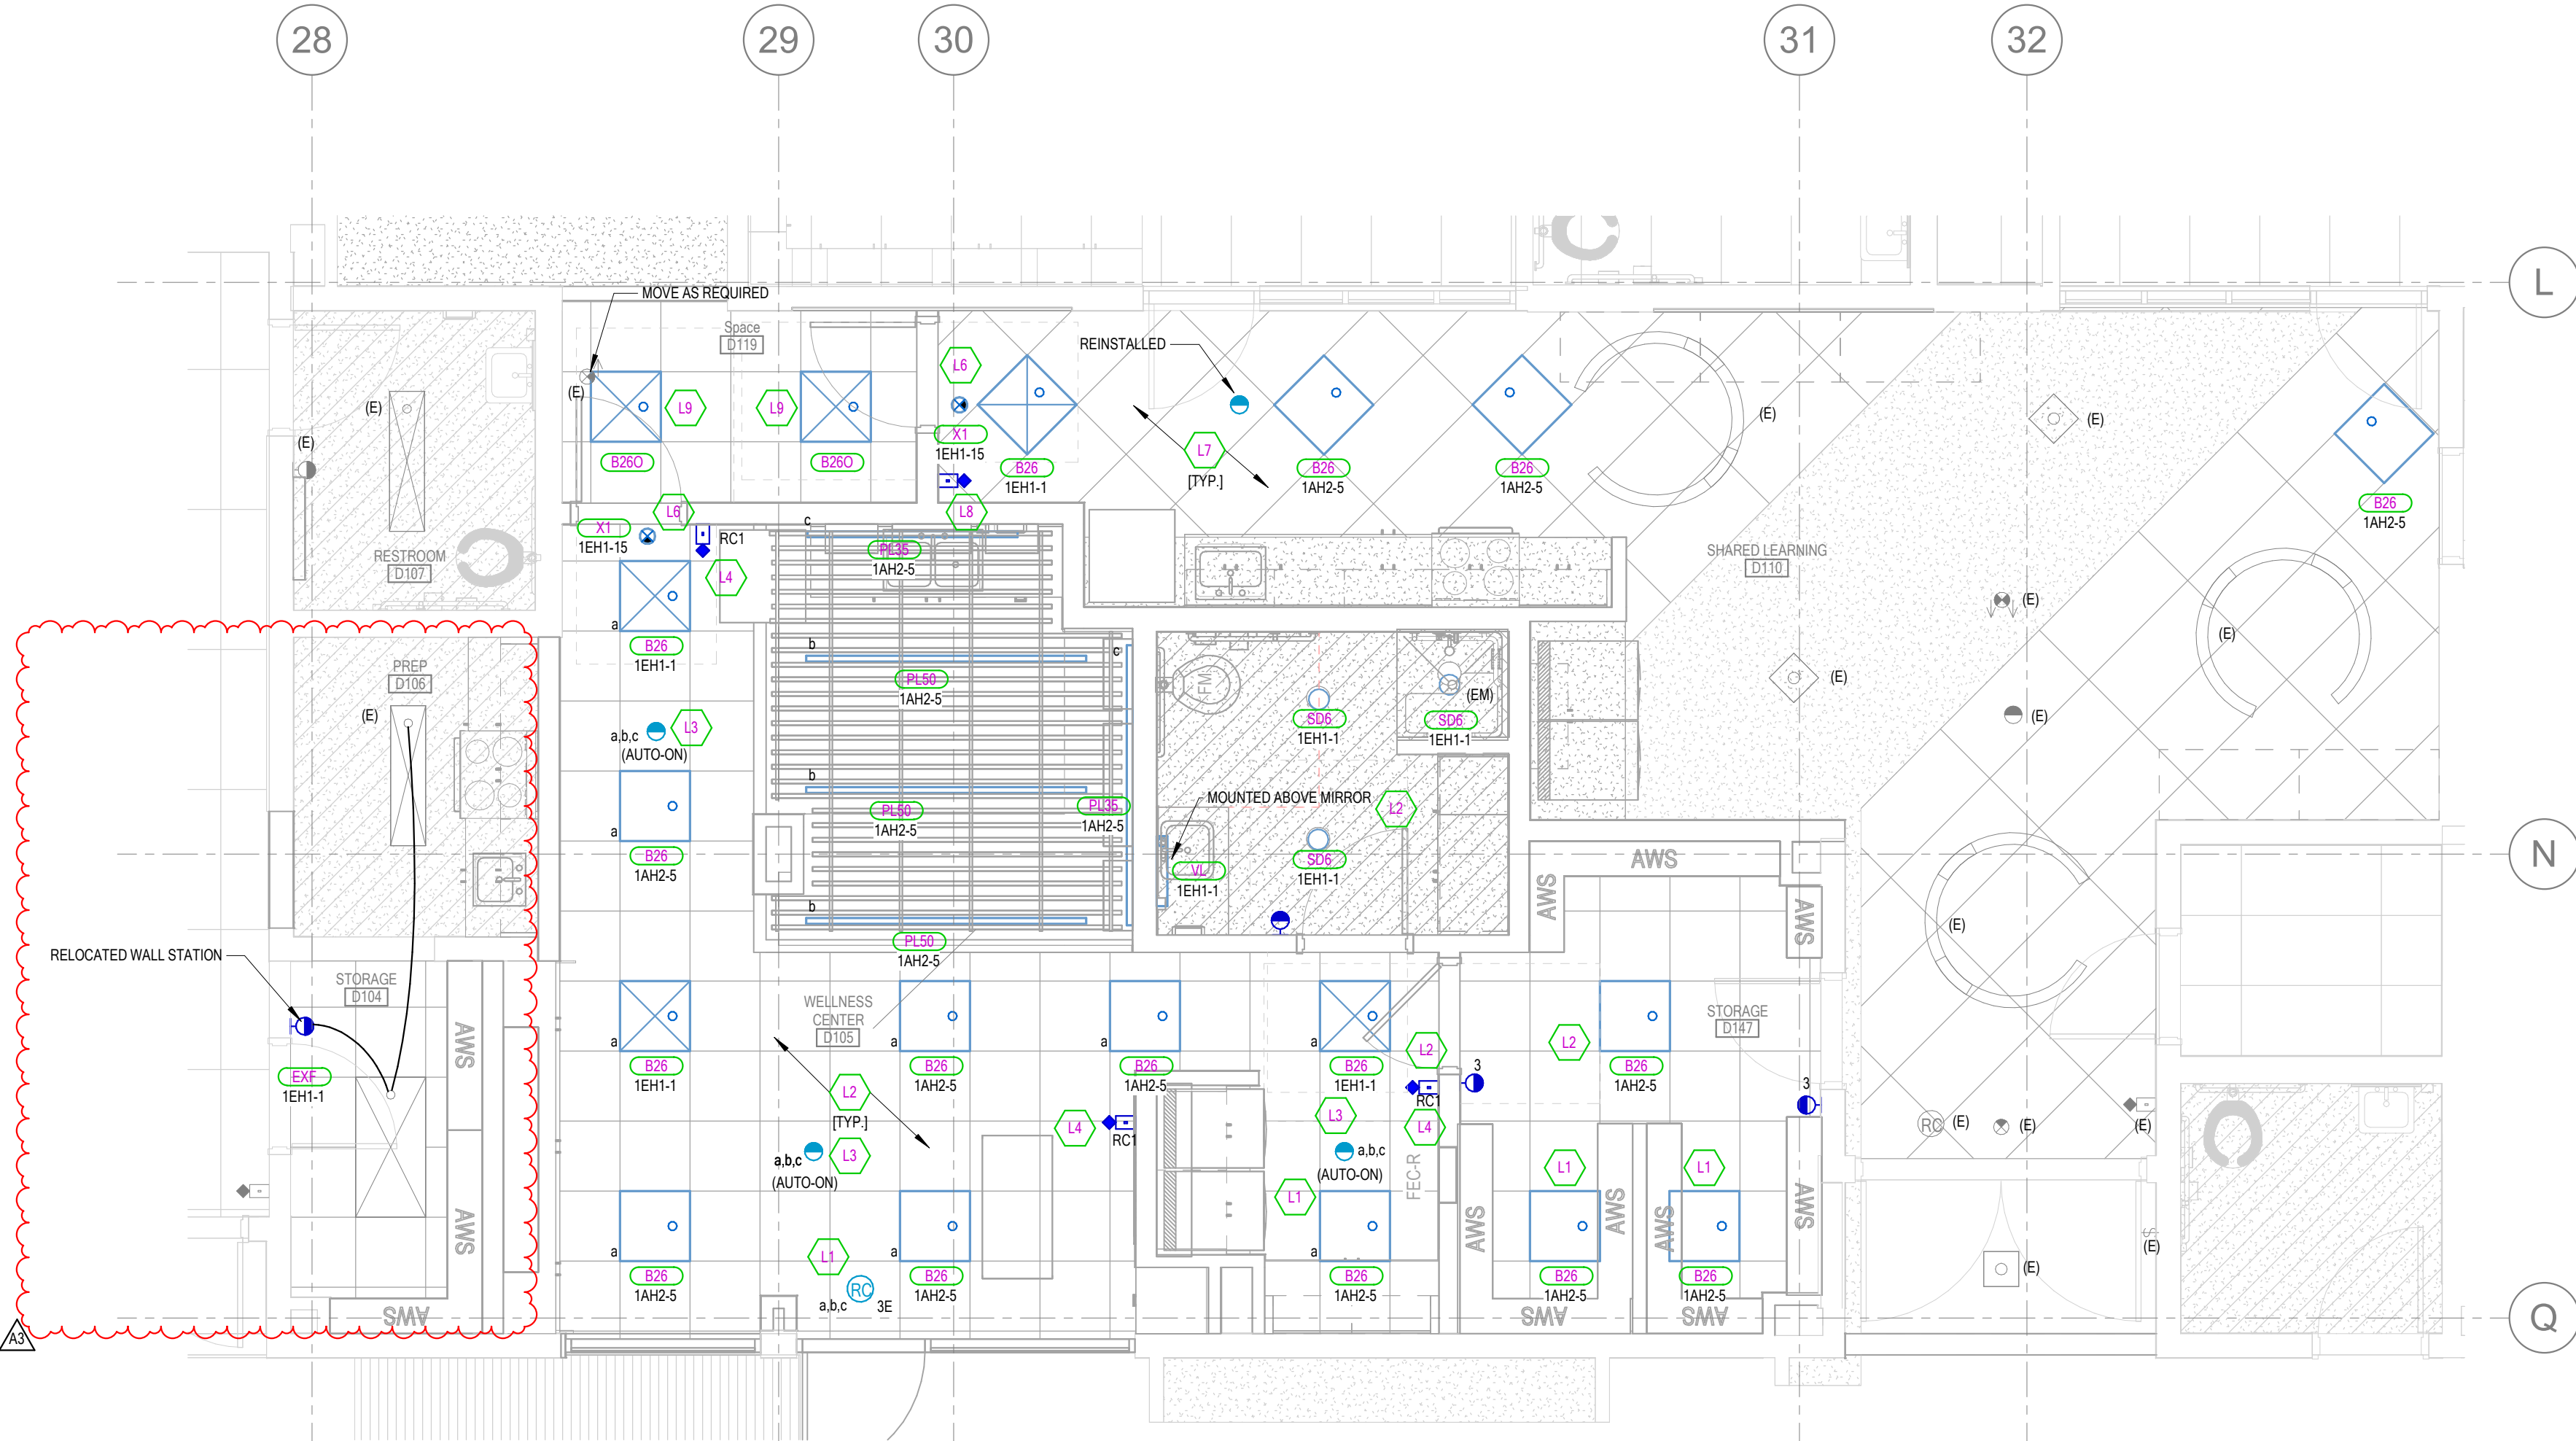

1 TEEN CENTER LIGHTING FLOOR PLAN
SCALE = 1/4" = 1'-0"

LIGHTING CONTROL INTENT NARRATIVE (IECC 2021 COMPLIANT)

THE DRAWINGS SHOW GENERAL ZONING INTENT. THE BIDDING CONTRACTOR ALONG WITH THE LIGHTING CONTROLS MANUFACTURER IS RESPONSIBLE FOR PROVIDING A SYSTEM WITH THE FEATURES NECESSARY AND MUST BE CAPABLE OF MEETING THE INTENT. THE MANUFACTURER'S REPRESENTATIVE FOR DIVISION 26 AND BIDDING CONTROLS SHALL BE ACCOUNTABLE FOR THE COMPREHENSIVE LIGHTING CONTROLS PACKAGE'S FINALIZATION IN ALIGNMENT WITH THE DESIGN INTENT DEPICTED IN THE DRAWINGS AND COMPLYING WITH IECC 2021 REQUIREMENTS. THE LIGHTING REPRESENTATIVE IS REQUIRED TO FURNISH EXHAUSTIVE SHOP DRAWINGS, ELUCIDATING THE LIGHTING CONTROL SYSTEMS TOPOLOGY AND THE ESSENTIAL CONNECTIONS NECESSARY FOR ITS PROPER FUNCTIONING.

GENERAL PRINCIPLES:

- ALL INDOOR AND OUTDOOR LIGHTING WILL BE CONTROLLED BY A SYSTEM THAT PRIORITIZES ENERGY EFFICIENCY AND OCCUPANT COMFORT, MEETING IECC 2021 REQUIREMENTS.
- LIGHTING WILL PRIMARILY FOLLOW A MASTER CLOCK SCHEDULE PROVIDED BY THE OWNER, WITH MANUAL OVERRIDE THROUGH TOUCH PANELS FOR FINE-TUNING.
- 0-10V DIMMING WILL BE AVAILABLE ON ALL APPLICABLE LUMINAIRES FOR SMOOTH LIGHT LEVEL ADJUSTMENTS.
- OCCUPANCY SENSORS WILL AUTOMATICALLY DIM LIGHTS TO PRESET LEVELS (50% FOR CORRIDORS, STAIRWELLS, VESTIBULES) AFTER PERIODS OF INACTIVITY (15 MINUTES).
- DAYLIGHT SENSORS WILL FURTHER ADJUST LIGHT LEVELS IN DESIGNATED ZONES BASED ON AVAILABLE NATURAL LIGHT.

SPECIFIC AREAS:

- PROVIDE WALL MOTION OCCUPANCY SENSOR, PROVIDE 20 MINUTE VACANCY MODE, WIRE EXHAUST FANS THROUGH WALL STATION.

REESTROOMS:

- PROVIDE 0-10V DIMMING WALL MOTION OCCUPANCY SENSOR, PROVIDE 2 MINUTE VACANCY MODE.

STORAGE:

- PROVIDE 0-10V DIMMING WALL MOTION OCCUPANCY SENSOR, PROVIDE 2 MINUTE VACANCY MODE.
- REMAINING SPACES:
- UPON ENTERING THE SPACE, THE OCCUPANT LIGHTS TURN ON AUTOMATICALLY TO 20%.
- OCCUPANTS CAN SET DESIRED LIGHT LEVELS FROM PRE-PROGRAMMED SCENES THROUGH THE WALL STATIONS.
- LIGHTS TURN OFF AUTOMATICALLY AFTER VACANCY OR A PRESET TIMEOUT PERIOD.
- EMERGENCY LUMINAIRES OPERATE ON THE SAME CIRCUIT AS NORMAL CLASSROOM LIGHTS.
- IN CASE OF A POWER FAILURE, DESIGNATED EMERGENCY LUMINAIRES/AUTOMATICALLY SWITCH TO 100% BRIGHTNESS.

RCI WALLSTATION:

- ALL ON: TURNS ALL LIGHTING RELAYS ON, BRINGING ALL DIMMING ZONES TO 100%.
- KITCHEN: TOGGLES ON/OFF KITCHEN LIGHTS (a), BRINGING (b) DIMMING ZONES TO 100%.
- GLOW: TOGGLES ON/OFF KITCHEN WALL WASHERS LIGHTS (a), BRINGING (c) DIMMING ZONES TO 100%.
- LIVING: TOGGLES ON/OFF LIVING/LAUNDRY AREA LIGHTS (a), BRINGING (a) DIMMING ZONES TO 100% (HIGH-END TRIM SETTING TO BE VERIFIED AND SET ON-SITE WITH OWNER/ENGINEER).
- RAISE & LOWER (PRESS AND HOLD), INCREASES OR DECREASES THE BRIGHTNESS OF ALL DIMMING ZONES.
- ALL OFF: TURNS OFF ALL LIGHTING LOADS.

COMPLIANCE:

THIS NARRATIVE OUTLINES A LIGHTING CONTROL SYSTEM THAT COMPLIES WITH THE LATEST IECC 2021 REQUIREMENTS, EMPHASIZING AUTOMATED CONTROLS, DAYLIGHT HARVESTING, AND ENERGY-EFFICIENT DIMMING BASED ON OCCUPANCY AND AMBIENT LIGHT LEVELS. THIS APPROACH HELPS MINIMIZE ENERGY CONSUMPTION WHILE ENSURING ADEQUATE LIGHTING FOR OCCUPANT SAFETY AND COMFORT.

EMERGENCY LIGHTING AND IECC/IEC COMPLIANCE
IN ADDITION TO THE STANDARD LIGHTING CONTROL SYSTEM, THE PROJECT WILL INCLUDE AN EMERGENCY LIGHTING SYSTEM DESIGNED TO MEET THE REQUIREMENTS OF THE INTERNATIONAL BUILDING CODE (IBC) AND THE INTERNATIONAL ENERGY CONSERVATION CODE (IECC). THIS SYSTEM PRIORITIZES OCCUPANT SAFETY AND EGRESS DURING POWER OUTAGES.

EMERGENCY LIGHTING FEATURES:

- DEDICATED CIRCUITS: EMERGENCY LUMINAIRES WILL BE CONNECTED TO SEPARATE, DEDICATED CIRCUITS THAT ARE NOT AFFECTED BY NORMAL POWER OUTAGES.
- AUTOMATIC ACTIVATION: UPON DETECTION OF A POWER FAILURE, EMERGENCY LIGHTS WILL AUTOMATICALLY SWITCH ON TO 100% BRIGHTNESS WITHIN THE FACILITY.
- GENERATOR BACKUP: THE EMERGENCY LIGHTING SYSTEM WILL BE BACKED UP BY A GENERATOR TO ENSURE SUSTAINED OPERATION DURING EXTENDED POWER OUTAGES.
- EXIT PATH ILLUMINATION: EMERGENCY LIGHTING WILL BE STRATEGICALLY PLACED TO EFFECTIVELY ILLUMINATE ALL DESIGNATED EXIT PATHS AND STAIRWELLS, FACILITATING SAFE EVACUATION.
- COMPLIANCE AND INSPECTION: THE EMERGENCY LIGHTING SYSTEM WILL BE DESIGNED AND INSTALLED IN ACCORDANCE WITH IBC AND IECC REQUIREMENTS, AND WILL BE SUBJECT TO REGULAR INSPECTIONS TO ENSURE PROPER FUNCTIONALITY.

ADDITIONAL NOTES:

- THE SPECIFIED TIME DELAYS AND LIGHT LEVELS CAN BE ADJUSTED TO SUIT THE SPECIFIC NEEDS OF THE BUILDING AND OCCUPANTS. AFTER 2 MONTHS OF OCCUPANCY, LIGHTING PROGRAMMER SHALL RETURN TO MAKE ADJUSTMENTS PER THE OWNERS REQUEST.

GENERAL NOTES

- CONFIRM SYSTEM TO MEET THE REQUIREMENTS OF IECC 2021 ON CURRENT ENERGY CODE.
- CONFIRM SWITCHING AND PROGRAMMING SCHEME WITH OWNER PRIOR TO PROGRAMMING.
- PROGRAM SYSTEM TO INCORPORATE AUTO DAYLIGHT SAVINGS ADJUSTMENTS, ASTRONOMICAL CLOCK WITH OFFSETS, HOLIDAY DATES, AND NETWORK OVERRIDE.
- REFER TO WALLSTATION DIAGRAMS FOR FACTORY ENGRAVED LABELING FOR ALL INDIVIDUAL PUSH-BUTTONS. DEVICE AND COVERPLATE COLORS SELECTED BY ARCHITECT.
- SUBMIT ALL WALLSTATION LAYOUTS, ENGRAVING AND CONTROL SEQUENCES DURING THE SHOP DRAWINGS REVIEW PROCESS.
- PROVIDE RELAY BARRIER FOR VOLTAGE AND POWER SOURCE SEPARATION (EMERGENCY AND NORMAL CIRCUITS, VOLTAGE DIFFERENCES).

LIGHTING GENERAL SHEET NOTES

- REFER TO ARCHITECTURAL REFLECTED CEILING PLANS FOR ALL FIXTURE LOCATIONS WITHIN A CEILING OR CEILING GRID. FOR AREAS WITHOUT CEILINGS, FIXTURE LOCATIONS ARE DIAGRAMMATIC. THE INTENT IS TO ALIGN CENTER, OR SPACE FIXTURES BETWEEN ARCHITECTURAL AND STRUCTURAL ELEMENTS. CONTRACTOR TO PLOT EXPOSED RACEWAY TO MATCH ADJACENT SURFACES.
- ELECTRICAL CONTRACTOR TO COORDINATE WITH MECHANICAL CONTRACTOR FOR PLACEMENT OF FIXTURES WITHIN MECHANICAL ROOMS.
- ALL ROOM CONTROLLERS AND/OR POWER PACKS SHALL BE INSTALLED IN THE CEILING SPACE DIRECTLY ABOVE THE ENTRY DOOR TO THE SPACE IT IS CONTROLLING.
- SEE CORRESPONDING LIGHTING DIAGRAMS FOR GENERAL INSTALLATION REQUIREMENTS, CONNECTIONS, AND CABLE TYPES.
- PROVIDE UNSWITCHED NORMAL CIRCUIT HOT LEG TO ALL EMERGENCY POWER CONTROL DEVICES FOR PROPER POWER SENSING.
- PROVIDE UNSWITCHED HOT AHEAD OF RELAY, OCCUPANCY SENSOR, OR SWITCH TO ALL EXIT SIGNS.
- IF SHOWN, SUBSCRIPT NEAR LIGHT FIXTURES INDICATES CONTROL INTENT. PROVIDE LIGHTING CONTROLLERS WITH THE REQUIRED NUMBER OF RELAYS/DIMMERS.
- MANUFACTURER'S REPRESENTATIVE FOR DIVISION 26 AND BIDDING CONTROLS SHALL BE ACCOUNTABLE FOR THE COMPREHENSIVE LIGHTING CONTROLS PACKAGE'S FINALIZATION IN ALIGNMENT WITH THE DESIGN INTENT DEPICTED IN THE DRAWINGS AND COMPLYING WITH IECC 2021 REQUIREMENTS. THE LIGHTING REPRESENTATIVE IS REQUIRED TO DEVELOP DETAILED SHOP DRAWINGS DEMONSTRATING THE LIGHTING CONTROL SYSTEMS TOPOLOGY AND THE ESSENTIAL CONNECTIONS NECESSARY FOR ITS PROPER FUNCTIONING. LIGHTING CONTROL DEVICES SHOWN ARE TO PROVIDE GENERAL INTENT ONLY. MANUFACTURER'S REPRESENTATIVE TO PROVIDE ALL ADDITIONAL DEVICES AND MODIFY DEVICE LOCATIONS AS REQUIRED TO MEET IECC 2021 REQUIREMENTS.
- PROVIDE ADDITIONAL RELAYS/DIMMERS FOR DAYLIGHT ZONES AS NEEDED. PROVIDE 0-10V DIMMING FOR ALL AREAS AND/OR ROOMS WHERE 0-10V DIMMING IS INDICATED BY THE WALLSTATION CONTROL SEQUENCE AND OR BY TYPE OF CONTROL INTERFACE SHOWN.

LIGHTING SENSOR GENERAL NOTES

- THE ELECTRICAL CONTRACTOR SHALL BE RESPONSIBLE FOR CONTACTING THE SENSOR MANUFACTURER FOR PROPER PLACEMENT AND ADJUSTMENT OF OCCUPANCY SENSORS.
- EACH ZONE SHALL HAVE COVERAGE BY OCCUPANCY SENSOR SUCH THAT NO BLIND SPOT EXIST.
- UPON COMPLETION OF THE INSTALLATION, THE SYSTEM SHALL BE COMPLETELY COMMISSIONED BY THE MANUFACTURER'S FACTORY AUTHORIZED TECHNICIAN WHO WILL VERIFY ALL ADJUSTMENTS AND SENSOR PLACEMENT TO ENSURE A TROUBLE-FREE INSTALLATION.
- THE LOCATION AND QUANTITIES OF SENSORS SHOWN ON THE DRAWINGS ARE DIAGRAMMATIC AND INDICATE ONLY THE ROOMS WHICH ARE TO BE PROVIDED WITH SENSORS. THE ELECTRICAL CONTRACTOR SHALL PROVIDE ADDITIONAL SENSORS AS REQUIRED TO PROPERLY COVER THE RESPECTIVE ROOM.
- PROVIDE DAYLIGHT ZONE CONTROL REQUIREMENTS PER IECC-2015 C405.2.2.3. LOCATE DAYLIGHT SENSOR(S) PER MANUFACTURER'S RECOMMENDATION AND WHERE REQUIRED WITHIN THE ROOM FOR PROPER COVERAGE.
- PROVIDE OCCUPANCY SENSOR WITH AN ADDITIONAL SET OF DRY CONTACTS FOR HVAC CONTROL AT EACH VAV BOX LOCATION.

SHEET KEYNOTES

- MOUNT ROOM CONTROLLER(S) ABOVE ENTRY DOOR ALONG WITH ANY OTHER RELATED MODULES. PROVIDE INDICATOR LABELING ON GRID TILE NEAREST THE ROOM CONTROLLER. COORDINATE WITH ARCHITECT FOR STYLE AND METHOD LABELING. SEE CORRESPONDING ROOM CONTROLLER DIAGRAM 5003 FOR MORE INFORMATION.
- PROVIDE NEW LIGHT FIXTURES AND CONTROLS AS SHOWN. WIRE NEW LIGHT FIXTURES TO LIGHTING CIRCUIT PREVIOUSLY FEEDING THIS CLASSROOM/AREA (EXISTING CIRCUITS PER RECORD DRAWINGS AND FOR REFERENCE ONLY).
- PROVIDE DUAL TECH. OCCUPANCY SENSOR(S) AS SHOWN. PROGRAM FOR AUTO-ON. LOCATE OCCUPANCY SENSOR(S) PER MANUFACTURER FOR PROPER PLACEMENT AND ADJUSTMENT OF OCCUPANCY SENSORS. PROVIDE ADDITIONAL SENSORS IF REQUIRED TO PROPERLY COVER THE RESPECTIVE ROOM.
- PROVIDE NEW LOW VOLTAGE WALLSTATION AS SHOWN. REFER TO NARRATIVE FOR LAYOUT AND CONTROL REQUIREMENTS.
- PROVIDE NEW EXIT SIGN AS SHOWN. WIRE INTO EXISTING UNSWITCHED EXIT SIGN CIRCUIT.
- PROVIDE NEW LIGHT FIXTURES AS SHOWN. WIRE NEW LIGHT FIXTURES INTO EXISTING SPD LIGHTING CONTROL CIRCUIT (EXISTING CIRCUITS PER RECORD DRAWINGS AND FOR REFERENCE ONLY).
- REINSTALL EXISTING LIGHTING WALLSTATION PREVIOUSLY REMOVED DURING DEMOLITION. REWORK AND REINSTALL IN NEW LOCATION AS SHOWN.
- PROVIDE NEW LIGHTS AND CONTROLS AS SHOWN. WIRE NEW LIGHTS INTO EXISTING STAIRWELL LIGHTING CIRCUIT.



MHTN Architects, Inc.
260 South 400 West
Suite 250
Salt Lake City, Utah 84101
Telephone (801) 595-6700
www.mhtn.com



4225 Lake Park Blvd., Suite 275
West Valley City, UT 84120
P: 801.532.2196
F: 801.532.2305
www.bnaconsulting.com




CANYONS
SCHOOL DISTRICT

Canyons School District
Brighton High School Teen Center
2220 BENGAL BLVD
COTTONWOOD HEIGHTS, UT 84121

2023 MHTN ARCHITECTS, INC.
Confidentiality Notice
This document is intended for use on the Project identified herein by individuals and companies involved in the design, permitting, bidding and construction of the Project identified herein. It is the property of MHTN Architects, Inc. and its use is restricted to the Project identified herein. No part of this document may be reproduced without the written consent of MHTN Architects, Inc. Any unauthorized reproduction or use of this document is prohibited. If a digital copy of this document is received in error, please delete it.

SEAL

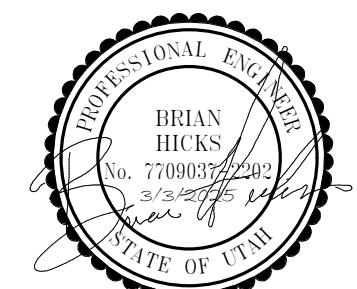

MHTN PROJECT NO. 2024516

Original drawing is 30" x 42". Do not scale contents of this drawing.

REVISIONS:
CONTRACTOR TO VERIFY DRAWINGS IN FIELD USE REFLECT
LAST REVISION DATE

NO.	DATE	DESCRIPTION
01	3/14/2025	ADDENDUM #3

ISSUE
CONSTRUCTION DOCUMENTS
MARCH 3, 2025

SHEET NAME
TEEN CENTER
LIGHTING FLOOR
PLAN

SHEET NUMBER

E201

Autodesk Docs: 2024516 CSD Brighton HS Teen Center CSD Brighton HS - Teen Center ELEC V24.rvt
3/14/2025 4:09:47 PM

A

B

C

D

Autodesk Docs: 2024516 CSD Brighton HS Teen Center CSD Brighton HS - Teen Center ELEC V24.rvt
3/14/2025 4:09:47 PM


1

2

3

4

5

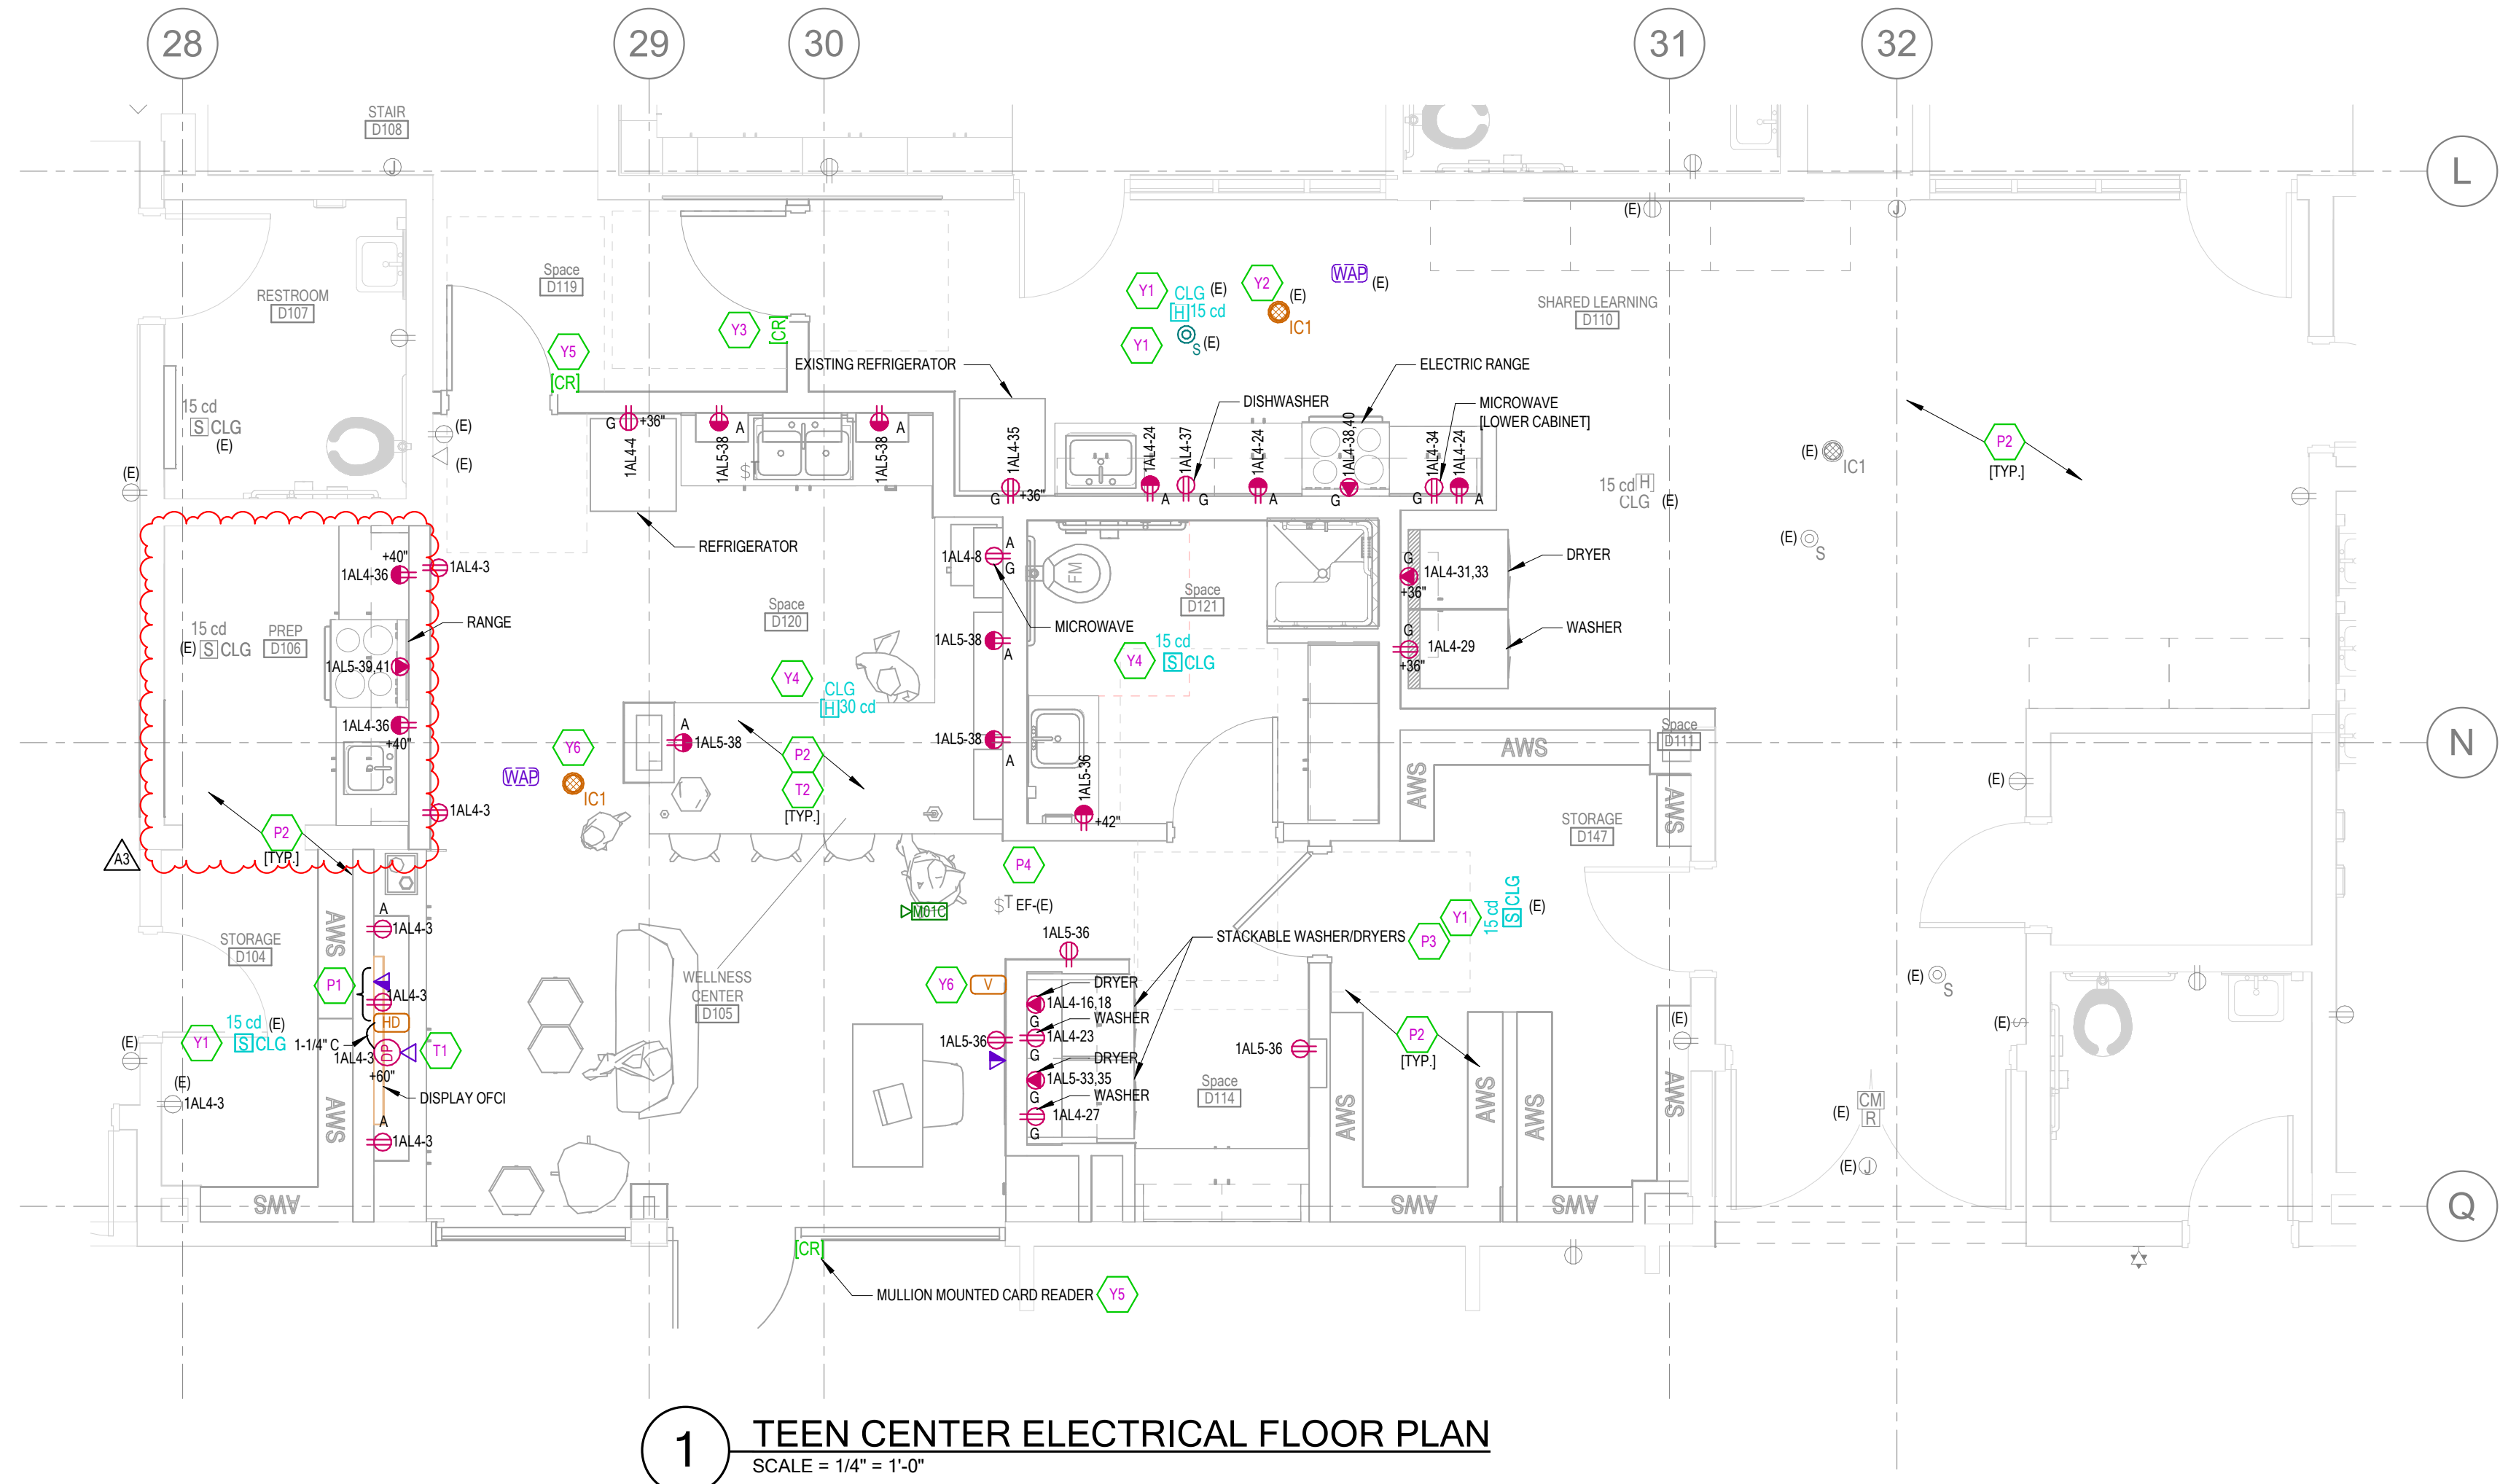

1 TEEN CENTER ELECTRICAL FLOOR PLAN
SCALE = 1/4" = 1'-0"

SHEET KEYNOTES

- LOCATE DEVICES WITHIN LOWER MILLWORK CABINET. COORDINATE WITH MILLWORK SHOP DRAWINGS PRIOR TO ROUGH-IN.
- PROVIDE NEW DEVICES AS SHOWN. CIRCUIT TO NEW OR EXISTING CIRCUITS AS INDICATED ON PLAN. VERIFY EXISTING CIRCUITING CONDITIONS AND MAINTAIN CIRCUIT INTEGRITY OF ANY ADDITIONAL DEVICES NOT SHOWN BUT WIRED TO THE EXISTING CIRCUIT.
- PROVIDE ELECTRICAL DEVICES REQUIRED FOR STACKABLE WASHERS AND DRYERS. COORDINATE WITH MILLWORK SHOP DRAWINGS AND ARCHITECTURAL ELEVATIONS FOR EXACT LOCATION AND HEIGHT PRIOR TO ROUGH-IN.
- EXISTING DRY BOOSTER EXHAUST FAN TO BE RELOCATED AND REWORK. DISCONNECT AND EXTEND ELECTRICAL CIRCUITRY TO NEW LOCATION AS REQUIRED. COORDINATE WITH DIV 23 FOR ADDITIONAL INFORMATION.
- PROVIDE FOR METAL PRODUCTS - PWB-3204 OR EQUAL DISPLAY BOX. BELOW THE DISPLAY AND WITHIN THE MILLWORK CABINET. PROVIDE 4 11/16" SQUARE JUNCTION BOX WITH EXTENSION SINGLE GANG MUDRING AND EXTRON WPD 110A PASS-THROUGH WALL PLATE. PROVIDE (1) 1-1/4" CONDUIT BETWEEN BOX AND DISPLAY BOX. PROVIDE EXTRON HDMI ULTRAFLEX CABLE AND TERMINATE AT WALL PLATE AND DISPLAY. VERIFY DISPLAY BOX AND DISPLAY HEIGHT WITH OWNER PRIOR TO ROUGH-IN.
- RUN ALL DATA DROPS FOR NEW DEVICES E.G. OUTLETS, CAMERAS, INTERCOM, ETC. TO EXISTING TELECOM RACK AND IDF D138 AND TERMINATE AS REQUIRED. SEE SPECIFICATIONS FOR MORE INFORMATION.
- REINSTALL EXISTING FIRE ALARM DEVICE PREVIOUSLY REMOVED DURING DEMOLITION. EXTEND EXISTING CIRCUIT AND REWORK AS REQUIRED.
- REINSTALL EXISTING INTERCOM SPEAKER DEVICE PREVIOUSLY REMOVED DURING DEMOLITION. EXTEND EXISTING CIRCUIT AND REWORK AS REQUIRED.
- REINSTALL EXISTING ELECTRIC STRIKE, CARD READER, AND ACS CIRCUIT PREVIOUSLY REMOVED DURING DEMOLITION. EXTEND EXISTING CIRCUIT AND REWORK AS REQUIRED.
- PROVIDE NEW HORNSTROBE AS SHOWN. TIE ONTO EXISTING FIRE ALARM LOOP.
- PROVIDE NEW CARD READER AND ACS CIRCUIT AS INDICATED AND WIRE COMPLETELY TIE INTO EXISTING ACS PANEL LOCATED IDF D138. SEE SPECIFICATIONS FOR MORE INFORMATION.
- PROVIDE NEW RAILAND TCU INTERCOM SPEAKER AND CALL SWITCH FOR NEW TEEN CENTER. PROVIDE NEW RAIL AND MOBILE AND CIRCUIT SPEC. GRADE CATEGORY CABLE BACK TO IDF 38 AND TERMINATE. COMPLETELY UPDATE SYSTEM ICS PROGRAM AS REQUIRED.

GENERAL ELECTRICAL SHEET NOTES

- COORDINATE PLACEMENT OF ELECTRICAL DEVICES WITH ARCHITECT PRIOR TO ROUGH-IN. WHERE DEVICES ARE SHOWN IN SAME WALL SPACE, ALIGN VERTICALLY AND HORIZONTALLY. COORDINATE WITH ARCHITECTURAL DRAWINGS AND CABINETRY DRAWINGS.
- ALL LOW VOLTAGE WIRE/CABLE FOR LIGHTING SENSORS, AUDIOVISUAL EQUIPMENT, SOUND AMPLIFICATION, ETC. TO BE ROUTED THROUGH CONDUIT IN EXPOSED AND CLOUDED CEILING AREAS.
- ALL LOW VOLTAGE WIRE/CABLE FOR LIGHTING SENSORS, AUDIOVISUAL EQUIPMENT, CLASSROOM SOUND AMPLIFICATION, ETC. TO BE PROPERLY SUPPORTED PER THE TELEDATA SPEC. AND AT 5'-0" INTERVALS AND TO FOLLOW BUILDING STRUCTURAL LINES. PULLING WIRE DIAGONALLY ACROSS ROOMS IS NOT ALLOWED. USING CEILING SYSTEM OR LIGHT FIXTURE SUPPORT/SEISMIC WIRES FOR SUPPORT IS NOT ALLOWED.
- PROVIDE GFCI PROTECTION ON ALL DEVICES AND EQUIPMENT PER THE NEC REQUIREMENTS. DEVICES SHALL BE READILY ACCESSIBLE. IF ANY OUTLET IS INSTALLED WITHIN 6 FEET OF OUTSIDE EDGE OF SINK, CONTRACTOR SHALL PROVIDE GFCI RECEPTACLE PER NEC, WHETHER SHOWN OR NOT.
- ALL RECEPTACLES LOCATED THROUGHOUT THE REMODEL SHALL BE TAMPER RESISTANT PER NEC 406.12.
- ELECTRICAL CONTRACTOR SHALL COORDINATE EXACT LOCATION OF ALL MECHANICAL UNITS WITH MECHANICAL CONTRACTOR. CIRCUITS TO ALL MECHANICAL EQUIPMENT SHALL BE DEDICATED UNLESS NOTED OTHERWISE.
- PROVIDE NEW DATA DROPS/OUTLETS AS SHOWN. ROUTE AND TERMINATE AT NEAREST TELECOM ROOM/IDF LOCATED IN THE EXISTING IDF D138.
- FIRE ALARM DEVICES SHOWN ARE FOR REFERENCE ONLY AND BASED UPON A PERFORMANCE SPECIFICATION. ALL NEW EQUIPMENT/DEVICES QUANTITIES, LOCATION AND ALL NATIONAL & LOCAL CODE COMPLIANCE TO BE PROVIDED AND STAMPED BY A LICENSED FIRE ALARM ENGINEER AND INCLUDED IN THE FIRE ALARM CONTRACTORS BID. IN NO WAY ARE THE DEVICES SHOWN ON THESE DRAWINGS TO BE IMPLEMENTED AS FINAL DESIGN DOCUMENTS.
- ANY FIRE ALARM DEVICE(S) REMOVED DURING DEMOLITION ARE REQUIRED TO BE RELOCATED IN THE LOCATION NECESSARY TO PROVIDE COVERAGE PER NFPA 72, AND CIRCUITED SAME AS BEFORE. FIRE ALARM DEVICES ARE NOT ALLOWED TO BE LOCATED CENTER OF ANY ROOM OR SPACE. IF MORE FIRE ALARM DEVICES ARE REQUIRED CONTRACTOR SHALL PROVIDE THEM COMPLETELY. REFER TO SHEET E401 FOR MORE INFORMATION. SEE NEW SHEET FOR NEW FIRE ALARM INFORMATION. REMOVE EXISTING FIRE ALARM DEVICE(S) AS NECESSARY FOR REMOVAL OF CEILING SYSTEM. RE-INSTALL ONCE NEW CEILING IS INSTALLED.
- CONTRACTOR SHALL COORDINATE EXACT LOCATION AND QUANTITY OF ALL DUCT TYPE SMOKE DETECTORS WITH MECHANICAL CONTRACTOR. HARDWARE TO RELAY STARTER.

PANELBOARD SCHEDULE

PANEL: 1AL4				TYPE: Type 1		VOLTS: 120/208 V		PHASE: 3		WIRES: 4								
MOUNTING: SURFACE				LOCATION: FED FROM:				MAINS: MLO										
BUSSING:				AMP: 225 A				SUBFEED LUGS DOOR-IN-DOOR ISO GROUND 200% NEUTRAL SPD										
BRANCH BREAKERS																		
ITEM	AMPS	TYPE	POLE	WIRE SIZE	CIR. NO.	A	B	C	A	B	C	WIRE SIZE	POLE	TYPE	AMPS	ITEM		
EXISTING CIRCUIT	20 A	--	1	--	1	0						4	12	1	--	20 A	EXISTING CIRCUIT	
** RECEPT - TEEN CENTER	20 A	--	1	--	3	1580	0					800	4	12	1	GF	20 A	** FRIDGE - TEEN CENTER
EXISTING CIRCUIT	20 A	--	1	--	5							0	6	1	--	20 A	EXISTING CIRCUIT	
EXISTING CIRCUIT	20 A	--	1	--	7							800	8	12	1	GF	20 A	* MICRO - TEEN CENTER
EXISTING CIRCUIT	20 A	--	1	--	9	0						0	10	1	--	20 A	EXISTING CIRCUIT	
EXISTING CIRCUIT	20 A	--	1	--	11		0					0	12	1	--	20 A	EXISTING CIRCUIT	
EXISTING CIRCUIT	20 A	--	1	--	13	0						0	14	--	1	--	20 A	EXISTING CIRCUIT
EXISTING CIRCUIT	20 A	--	1	--	15		0					4000	16	10	2	GF	30 A	** DYER - TEEN CENTER
EXISTING CIRCUIT	20 A	--	1	--	17		0					4000	18	--	--	--	--	--
EXISTING CIRCUIT	20 A	--	1	--	19	0						0	20	--	1	--	20 A	EXISTING CIRCUIT
EXISTING CIRCUIT	20 A	--	1	--	21	0						0	22	--	1	--	20 A	EXISTING CIRCUIT
** WASHER - TEEN CENTER	20 A	GF	1	12	23			180				540	24	12	1	20 A	** RECEPT, SHARED LEARNING	
EXISTING CIRCUIT	20 A	--	1	--	25	0						0	26	--	1	--	20 A	EXISTING CIRCUIT
** WASHER - TEEN CENTER	20 A	GF	1	12	27			180				0	28	--	1	--	20 A	EXISTING CIRCUIT
** WASHER - TEEN CENTER	20 A	GF	1	12	29			180				0	30	--	1	--	20 A	EXISTING CIRCUIT
** DRYER - TEEN CENTER	30 A	GF	2	10	31	4000						32	--	1	--	20 A	EXISTING CIRCUIT	
--	--	--	--	--	33		4000					34	--	1	--	20 A	** RECEPT, TEEN CENTER	
** FRIDGE - TEEN CENTER	20 A	GF	1	36				800				980	36	1	--	20 A	** RECEPT, TEEN CENTER	
** DW- TEEN CENTER	20 A	GF	1	37	1200			4000				38	2	GF	50 A	** RANGE - TEEN CENTER		
EXISTING CIRCUIT	20 A	--	1	--	39	0						4000	40	--	--	--	--	--
EXISTING CIRCUIT	20 A	--	1	--	41							0	42	--	1	--	20 A	EXISTING CIRCUIT
FEED THRU LOAD						10000	15360	6680	TOTAL (VA)			CONNECTED LOAD TOTAL						
0 VA						88 A	132 A	56 A	AMPS/PHASE			32040 VA						
AIC RATING																AMPS RMS SYSTM.		
Load Classification		Connected Load		Demand Factor		Estimated Demand		Panel Totals										
Other		500 VA		100.00%		500 VA												
RECEPT		16000 VA		81.25%		13000 VA		Total Conn. Load: 32040 VA										
RECEPTACLE		6340 VA		100.00%		6340 VA		Total Est. Demand: 29040 VA										
* DISHWASHER		1200 VA		100.00%		1200 VA		Total Conn. Current: 89 A										
* RANGE/OVEN		8000 VA		100.00%		8000 VA		Total Est. Demand Current: 81 A										
NOTES:																		
EXISTING GE A-SERIES II PANELBOARD																		
*UTILIZE EXISTING 20A/1P SPARE																		
**REWORK EXIST. CIRCUIT & RE-USE BREAKER																		
***PROVIDE NEW BREAKER AS INDICATED (RE-WORK CIR. AS REQUIRED)																		
-BLANK- THERMAL MAGNETIC CIRCUIT BREAKER																		
GF 5 mA GROUND FAULT CIRCUIT BREAKER																		
AF ARC-FAULT CIRCUIT BREAKER																		
CO COMBINATION AFCI/GFCI CIRCUIT BREAKER																		
EG 30 mA EQUIPMENT GROUND FAULT CIRCUIT BREAKER																		
ST SHUNT TRIP CIRCUIT BREAKER																		

PANELBOARD SCHEDULE

PANEL: 1AL5	TYPE: Type 1	VOLTS: 120/208 V	PHASE: 3	WIRES: 4													
MOUNTING: SURFACE	LOCATION:	FED FROM:	MAINS: MLO	SUBFEED LUGS													
BUSSING:	AMP: 225 A			DOOR-IN-DOOR													
				ISO GROUND													
				200% NEUTRAL													
				SPD													
BRANCH BREAKERS																	
ITEM	AMPS	TYPE	POLE	WIRE SIZE	CIR. NO.	A	B	C	A	B	C	WIRE SIZE	POLE	TYPE	AMPS	ITEM	
EXISTING CIRCUIT	20 A	--	1	--	1	0						2	--	1	--	20 A	EXISTING CIRCUIT
EXISTING CIRCUIT	20 A	--	1	--	3	0						4	--	1	--	20 A	EXISTING CIRCUIT
EXISTING CIRCUIT	20 A	--	1	--	5	0						6	--	1	--	20 A	EXISTING CIRCUIT
EXISTING CIRCUIT	20 A	--	1	--	7	0						8	--	1	--	20 A	EXISTING CIRCUIT
EXISTING CIRCUIT	20 A	--	1	--	9	0						10	--	1	--	20 A	EXISTING CIRCUIT
EXISTING CIRCUIT	20 A	--	1	--	11	0						12	--	1	--	20 A	EXISTING CIRCUIT
EXISTING CIRCUIT	20 A	--	1	--	13	0						14	--	1	--	20 A	EXISTING CIRCUIT
EXISTING CIRCUIT	20 A	--	1	--	15	0						16	--	1	--	20 A	EXISTING CIRCUIT
EXISTING CIRCUIT	20 A	--	1	--	17	0						18	--	1	--	20 A	EXISTING CIRCUIT
EXISTING CIRCUIT	20 A	--	1	--	19	0						20	--	1	--	20 A	EXISTING CIRCUIT
EXISTING CIRCUIT	20 A	--	1	--	21	0						22	--	1	--	20 A	EXISTING CIRCUIT
EXISTING CIRCUIT	20 A	--	1	--	23	0						24	--	1	--	20 A	EXISTING CIRCUIT
EXISTING CIRCUIT	20 A	--	1	--	25	0						26	--	1	--	20 A	EXISTING CIRCUIT
EXISTING CIRCUIT	20 A	--	1	--	27	0						28	--	1	--	20 A	EXISTING CIRCUIT
EXISTING CIRCUIT	20 A	--	1	--	29	0						30	--	1	--	20 A	EXISTING CIRCUIT
EXISTING CIRCUIT	20 A	--	1	--	31	0						32	--	1	--	20 A	EXISTING CIRCUIT
*** DRYER - TEEN CENTER	30 A	GF	2	10	33	4000						34	--	1	--	20 A	EXISTING CIRCUIT
--	--	--	--	--	35		4000					720	36	1	12	20 A	* RECEPT - TEEN CENTER
SPARE	20 A	--	1	--	37	0						38	--	1	12	20 A	* RECEPT - TEEN CENTER
*** RANGE - TEEN CENTER	50 A	GF	2	8	39	4000						40	--	1	--	20 A	SPARE
--	--	--	--	--	41		4000					42	--	1	--	20 A	SPARE
FEED THRU LOAD						900	8000	8720	TOTAL (VA)								CONNECTED LOAD TOTAL
0 VA						8 A	76 A	82 A	AMPS/PHASE								17620 VA
AIC RATING										AMPS RMS SYSTM.							
Load Classification		Connected Load		Demand Factor		Estimated Demand		Panel Totals									
RECEPT		16000 VA		81.25%		13000 VA		Total Conn. Load: 17620 VA									
RECEPTACLE		1620 VA		100.00%		1620 VA		Total Est. Demand: 14620 VA									
										Total Conn. Current: 40 A							
										Total Est. Demand Current: 41 A							
NOTES:																	
EXISTING GE A-SERIES II PANELBOARD										CIRCUIT BREAKER TYPE:							
										-BLANK- THERMAL MAGNETIC CIRCUIT BREAKER							
										GF 5 mA GROUND FAULT CIRCUIT BREAKER							
*UTILIZE EXISTING 20A/1P SPARE										ARCO-FAULT CIRCUIT BREAKER							
**REWORK EXIST. CIRCUIT & RE-USE BREAKER										COMBINATION AFCI/GFCI CIRCUIT BREAKER							
***WIRE NEW BREAKER AS INDICATED (RE-WORK CIR. AS REQUIRED)										30-mA EQUIPMENT GROUND FAULT CIRCUIT BREAKER							
										ST SHUNT TRIP CIRCUIT BREAKER							

